IREDELL COUNTY HEALTH DEPARTMENT

STATESVILLE 704-878-5305 MOORESVILLE 704-664-5281

IMPROVEMENT PERMIT / AUTHORIZATION TO CONSTRUCT / OPERATION PERMIT / EXISTING SYSTEM INSPECTION

PERMIT# ~~10617~~ 11949 PIN# ~~4646 20 4611. 76~~ 4646-28-5652 DATE 8/21/02

OWNER OR CONTRACTOR DIENST ENTERPRESES / RYAN HOMES PHONE: Business 309-0123 Home

ADDRESS 19315 W. CATAWBA AVE. SUITE 200 CORNELIUS NC 28031

LOCATION WILLIAMSON - TR SUNDOWN - TR SUNDOWN COVE - ON RT

SUBDIVISION ESTATES @ SUNDOWN BLOCK / SECTION LOT 76 LOT AREA 25000 SITE CLASS. RS DESIGN FLOW 480GPD L.T.A.R. .36 IGPD

Septic Tank: 1000 Gallons; STB 312 Date 3/21/04

Pump Tank: 1000 Gallons; PT 27 Date 3/20/04

Pump Make: Model Serial No.

Nitrification Field: No Fields 1 Square Feet 560 Linear Feet 280

No Lines 4 @ 70' Trench Width 24" Max Trench Bottom Depth 36" Gravel Depth N/A

☑ New System ☐ Repair System Type: I, II, III, IV, V, VI

System Description: LP PANEL

Repair System Description: SAME

Maintenance Agreement Required: ☑ Yes ☐ No

☑ House/Mod. Home No. Bedrooms 4

☐ Mobile Home No. Bathrooms 4

☐ Business No. Employees

☐ Other


☐ Slab ☑ Crawl Space ☐ Basement w/plumbing ☐ Basement wo/plumbing

Water Supply: ☐ Individual ☐ Public ☑ Community

Comments:/Conditions: 1) INLINE PUMP FILTER TO BE INSTALLED

Comments:/Conditions: Tanks checked 4/23/04 by GM
Checked lines 4/30/04
Checked pressure, elkat & alarm 5/19/04 MS

INITIAL SITE SKETCH 1" = 50'

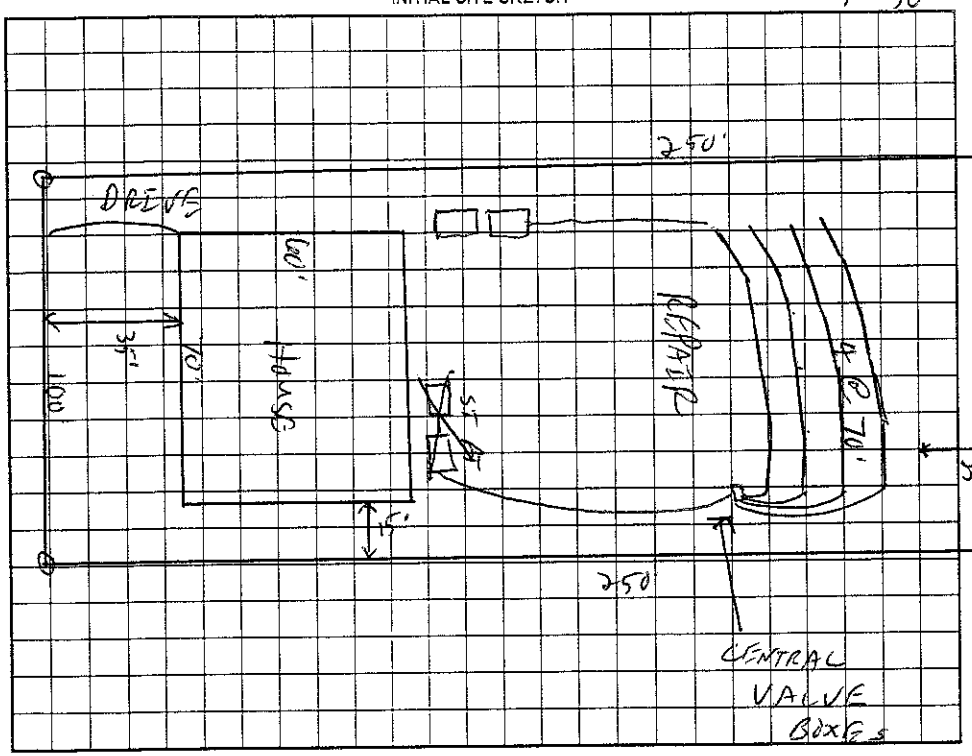

AS BUILT SKETCH

Permit can be suspended or revoked if any false information is supplied toward securing the permit/any unauthorized changes are made to the site/any unauthorized changes are made in the installation of the system. Improvement Permit with plat valid without expiration. Improvement Permit with site plan valid for sixty months. Authorization to Construct is valid for a period equal to that of Improvement Permit – not to exceed sixty months.

Signed: Robert B. Dienst date 9/20/02

Improvement Permit by: C. [illegible] RS date 8/21/02

Authorization to Construct by: [illegible] RS date 3-24-04

Installed by: R + H date

Operation Permit by: Maria [illegible] Dolson RS date 5/21/04

Existing System Inspection by: date

HEALTH DEPT. COPY: WHITE OWNER COPY (FINAL): YELLOW OWNER COPY (INITIAL): PINK