IREDELL COUNTY HEALTH DEPARTMENT

STATESVILLE 704-878-5305 MOORESVILLE 704-664-5281

IMPROVEMENT PERMIT / AUTHORIZATION TO CONSTRUCT / OPERATION PERMIT / EXISTING SYSTEM INSPECTION

PERMIT# 108605 PIN# ~~4646-25-4611.62~~ 4646-28-5867 DATE 10/25/02

OWNER OR CONTRACTOR DIENST ENTERPRISES / Ryan Homes PHONE: Business 309-0183 Home

ADDRESS 105 EASTON DRIVE MOORESVILLE NC 28117

LOCATION WILLIAMSON - TR SUNDOWN - TR SUNDOWN COVE - TR CORONA - TL CORONA - ON LT

SUBDIVISION ESTATES @ SUNDOWN BLOCK / SECTION 2 LOT 62 LOT AREA 25000 ft² SITE CLASS. PS DESIGN FLOW 480GPD L.T.A.R. .2 GPD/FT²

Septic Tank: 1000 Gallons; STB 1904 Date 8-19-05
Pump Tank: 1000 Gallons; PT 27 Date 8-20-05
Pump Make Gould's Model WE05111 Serial No.
Nitrification Field: No Fields 1 Square Feet 798 Linear Feet 399
No Lines 3@133 Trench Width 24" Max Trench Bottom Depth 36" Gravel Depth N/A

☑ New System ☐ Repair System Type: I, II, III, (IV), V, VI
System Description: LP PANEL
Repair System Description: SAME
Maintenance Agreement Required: ☑ Yes ☐ No

☑ House/Mod. Home No. Bedrooms 4
☐ Mobile Home No. Bathrooms 2
☐ Business No. Employees
☐ Other


Water Supply: ☐ Individual ☐ Public ☑ Community

☐ Slab ☑ Crawl Space ☐ Basement w/plumbing ☐ Basement wo/plumbing

Comments/Conditions: ~~Drive on other side.~~ Building plans reviewed; essentially as drawn in I.P.


Comments/Conditions: 12/05 Checked tanks & lines 9/22/05 Pressure, elect & alarm 11/8/05

INITIAL SITE SKETCH 1"=50'

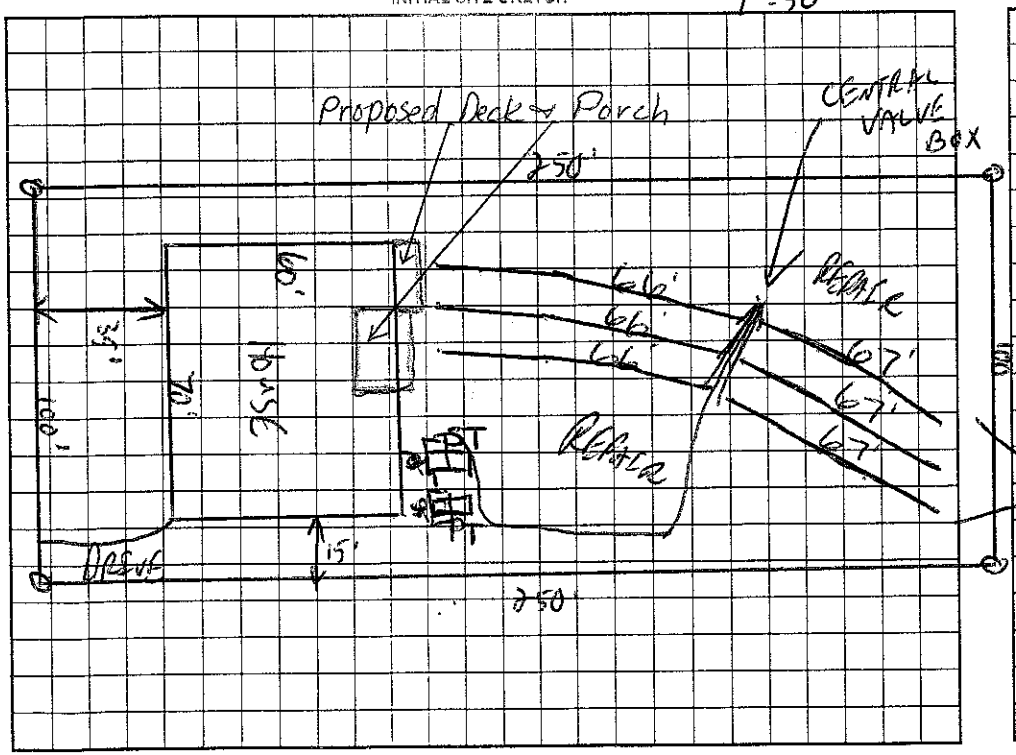

AS BUILT SKETCH

Installed as Drawn

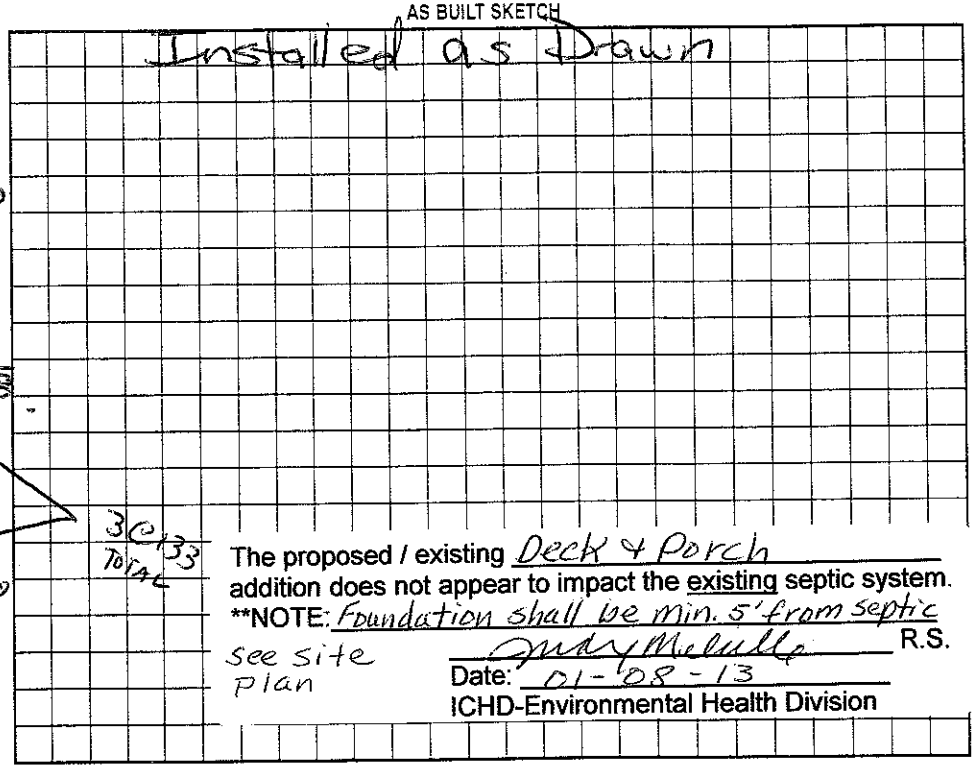

The proposed / existing Deck & Porch addition does not appear to impact the existing septic system.
**NOTE: Foundation shall be min. 5' from septic
see site plan

Andy Melville R.S.
Date: 01-08-13
ICHD-Environmental Health Division

Permit can be suspended or revoked if any false information is supplied toward securing the permit/any unauthorized changes are made to the site/any unauthorized changes are made in the installation of the system. Improvement Permit with plat valid without expiration. Improvement Permit with site plan valid for sixty months. Authorization to Construct is valid for a period equal to that of Improvement Permit – not to exceed sixty months.

Signed: Robert B. Dienst date 11/27/02

Improvement Permit by: [signature] RS date 10/25/02

Authorization to Construct by: [signature] RS date 7/18/05

Installed by: R & T RS

Operation Permit by: [signature] date 11/8/05

Existing System Inspection by: date

HEALTH DEPT. COPY: WHITE OWNER COPY (FINAL): YELLOW OWNER COPY (INITIAL): PINK