IREDELL COUNTY HEALTH DEPARTMENT

STATESVILLE 704-878-5305 MOORESVILLE 704-664-5281

IMPROVEMENT PERMIT / AUTHORIZATION TO CONSTRUCT / OPERATION PERMIT / EXISTING SYSTEM INSPECTION

PERMIT# 106059 PIN# ~~4646204611.77~~ 4646-28-6652 DATE 8/23/02

OWNER OR CONTRACTOR DIENST ENTERPRISES / RYAN HOMES PHONE: Business 309-0183 Home

ADDRESS 19315 W. CATAWBA AVE SUITE 200 CORNELIUS NC 28031

LOCATION WILLIAMSON - TR SUNDOWN - TR SUNDOWN COVE - ON LT

SUBDIVISION ESTATES @ SUNDOWN BLOCK / SECTION 2 LOT 77 LOT AREA 25600 ft² SITE CLASS. PS DESIGN FLOW 360GPD L.T.A.R. ~.25 gal/ft²

Septic Tank: 1000 Gallons; STB ~~312~~ Date 6-1-04
Pump Tank: 1000 Gallons; PT ~~283~~ Date 3-22-05
Pump Make: Model Serial No.
Nitrification Field: No Fields 1 Square Feet 500 Linear Feet 250
No Lines 5 @ 50' Trench Width 24" Max Trench Bottom Depth 36" Gravel Depth NA

☑ New System ☐ Repair System Type: I, II, III, (IV), V, VI
System Description: LP PANEL
Repair System Description: SAME
Maintenance Agreement Required: ☑ Yes ☐ No


☑ House/Mod. Home No. Bedrooms 3
☐ Mobile Home No. Bathrooms 3
☐ Business No. Employees
☐ Other
☐ Slab ☑ Crawl Space ☐ Basement w/plumbing ☐ Basement wo/plumbing

Water Supply: ☐ Individual ☐ Public ☐ Community

Comments/Conditions: 1) INLINE PUMP FILTER TO BE INSTALLED

Comments/Conditions: Checked tanks & lines 5-4-05

INITIAL SITE SKETCH 1"=50'

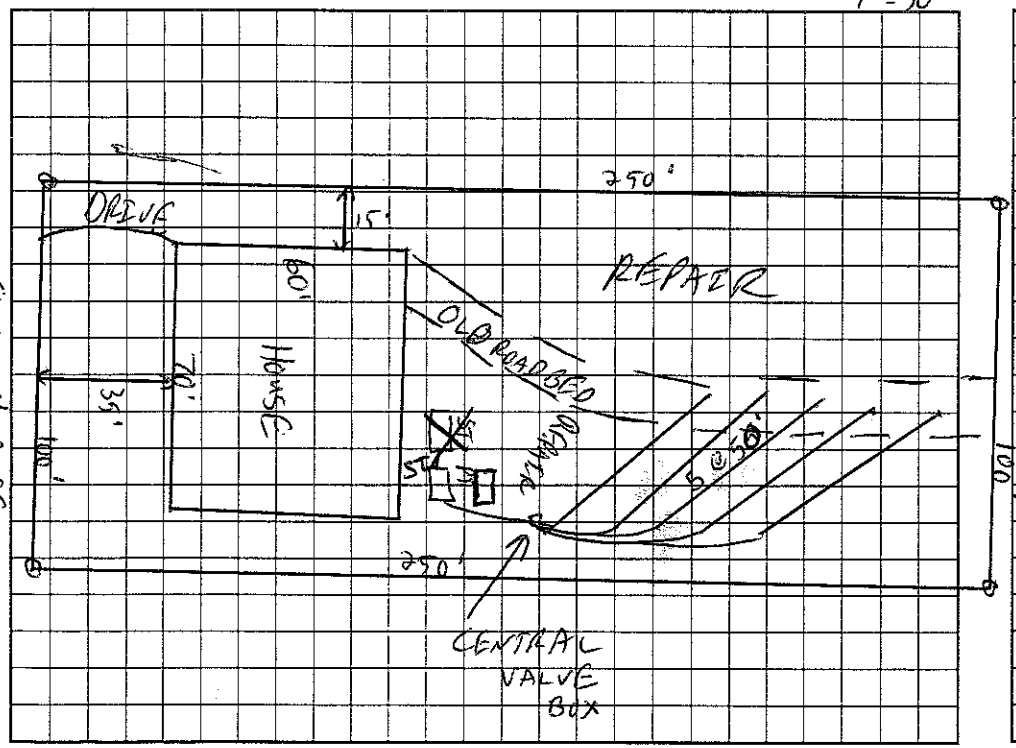

AS BUILT SKETCH

Installed Panel Lines Essentially as Drawn

Permit can be suspended or revoked if any false information is supplied toward securing the permit/any unauthorized changes are made to the site/any unauthorized changes are made in the installation of the system. Improvement Permit with plat valid without expiration. Improvement Permit with site plan valid for sixty months. Authorization to Construct is valid for a period equal to that of Improvement Permit – not to exceed sixty months.

Signed: Robert B. Dienst date 9/20/02 Installed by: R & H RS

Improvement Permit by: C. [illegible] RS date 8/23/02 Operation Permit by: Maria H. Dolson date 6/15/05

Authorization to Construct by: Wesley Sparks RS date 2/9/05 Existing System Inspection by: date

HEALTH DEPT. COPY: WHITE OWNER COPY (FINAL): YELLOW OWNER COPY (INITIAL): PINK