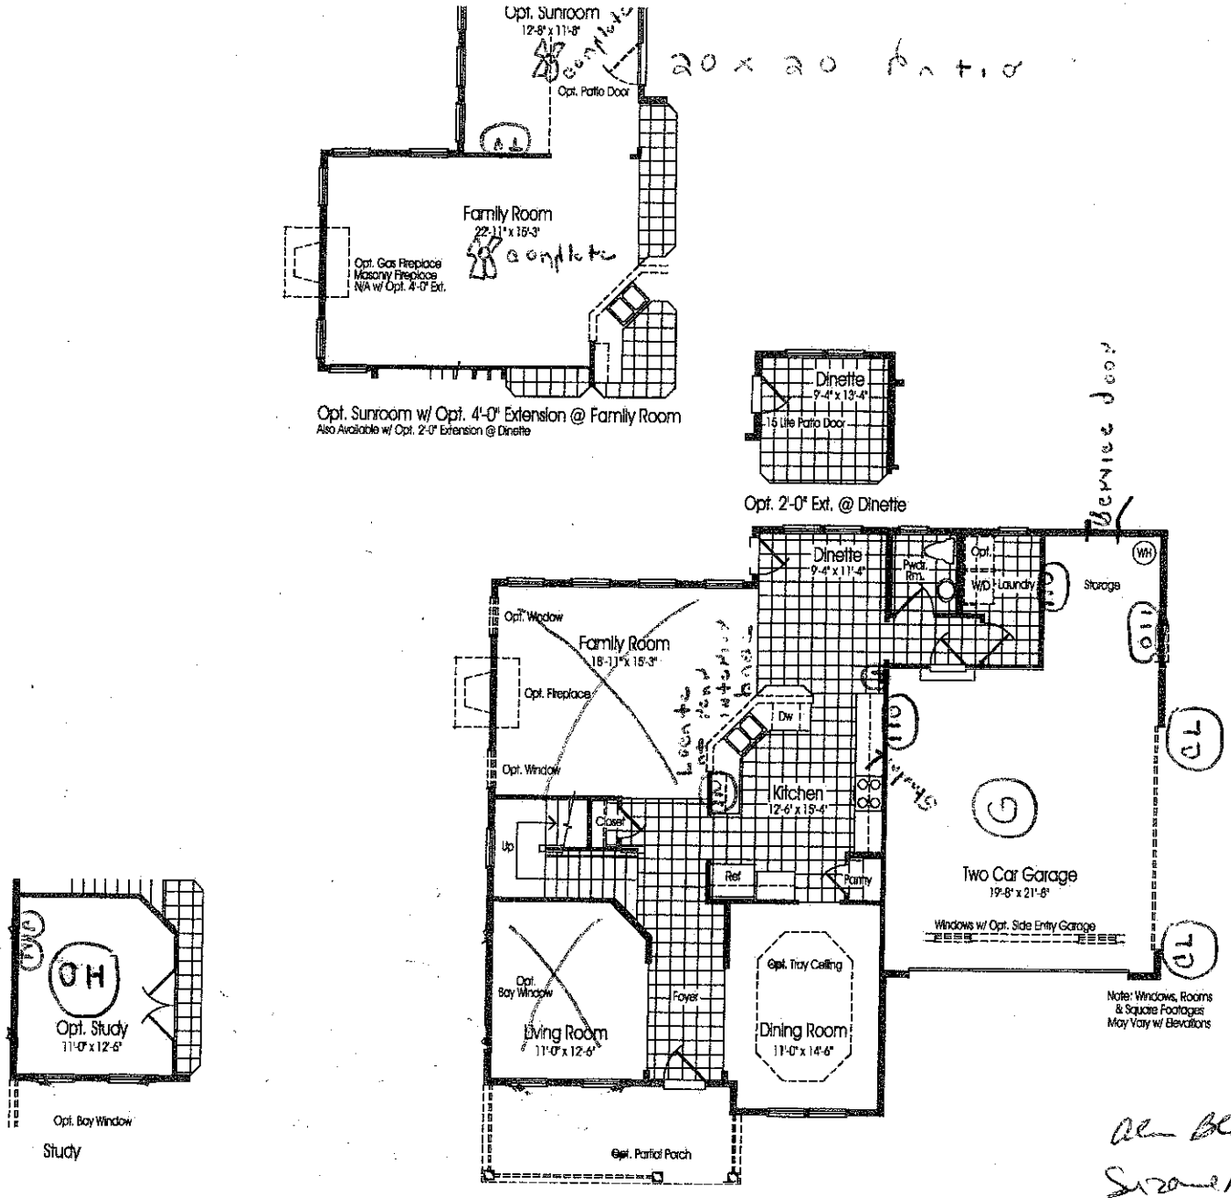


20 x 20 patio

3 Bdrm


Acknowledgement Of Plans Submittal ONLY!
W Lyons RS Date 2-9-05
C Cushenberry Date 2/9/05

Alan Bailey
Suzanne Bailey

5044

MAIN LEVEL
ELEVATION C

Although all illustrations and specifications are believed correct at the time of publication, the right is reserved to make changes, without notice or obligation. Windows, doors, ceilings, and room sizes may vary depending on the options and elevations selected. Optional items indicated are available at additional cost. This brochure is for illustrative purposes only and not part of a legal contract. It is recommended that the architectural blueprints be reviewed for further clarification of features. Not all features are shown. Please ask our Sales and Marketing Representative for complete information.

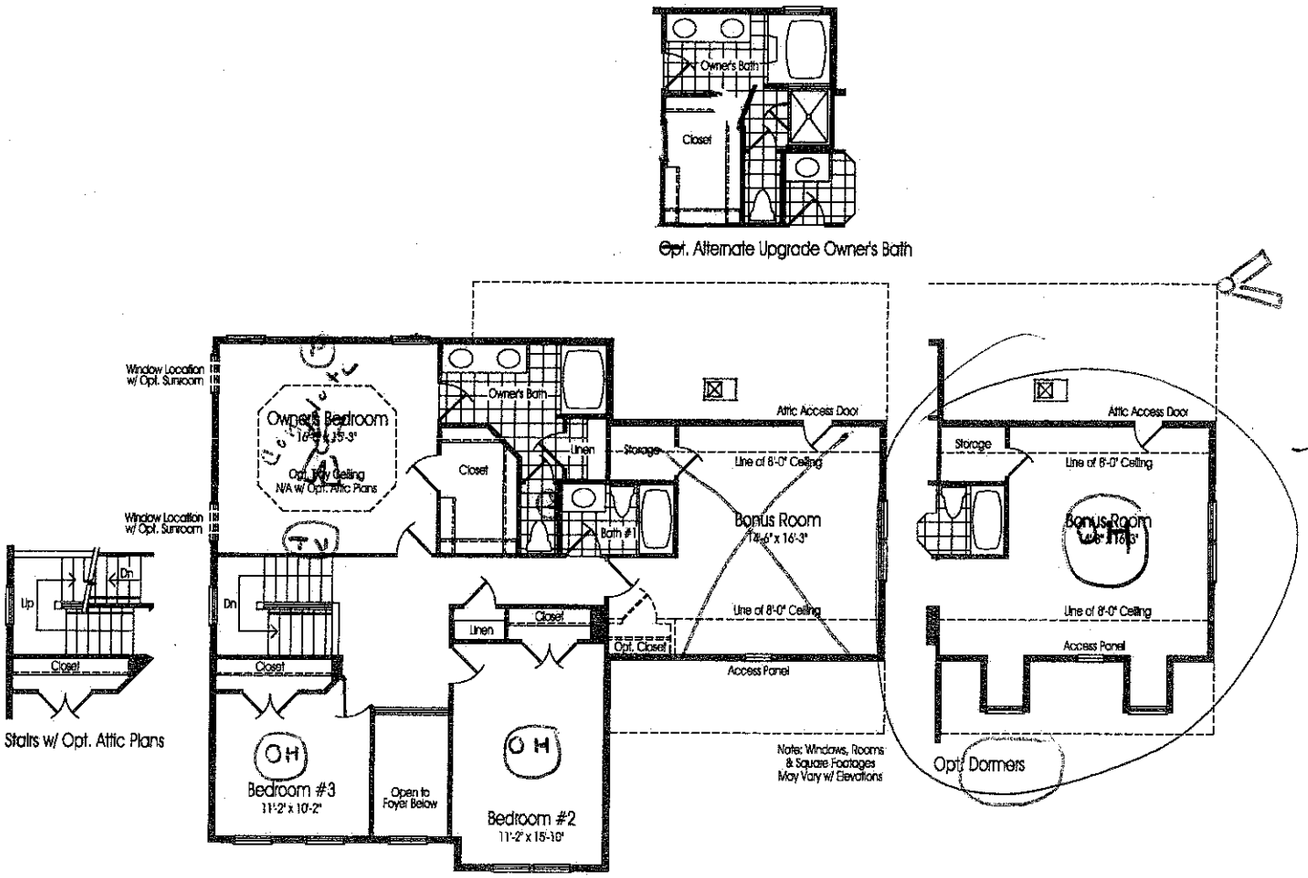

no Doorways
C. Schuette
2/9/16

UPPER LEVEL
ELEVATION C

as Built
Suzanne Blaby

5044

THE PINECLIFF

5044

Blankley

(P) Telephone - 5 / (OH) Overhead lights - 4

(TV) Cable - 4 / (110) 110 outlets - 3

Complete - Complete ceiling fans - 3 /

Ceiling fan prewire - 1 /


(CL) Coach lights - 2 / (G) Garage prewire - 1

Floodlight - 1 /


C. Corbett

NO DOORWAYS

CC 2/9/05

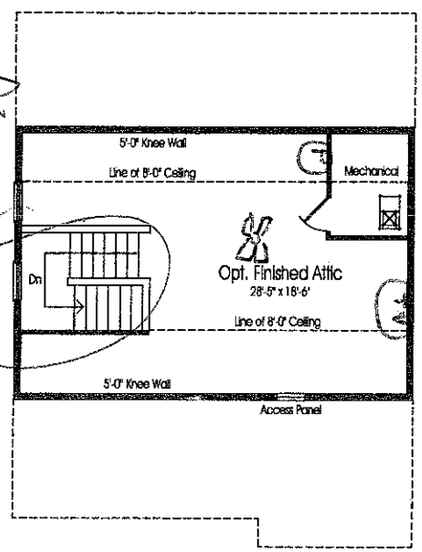

Opt. Attic - Finished

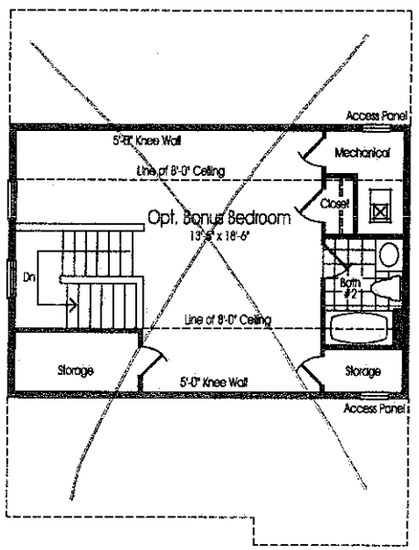

~~Opt. Attic w/ Opt. Bonus Bedroom~~

ATTIC LEVEL

ELEVATION C

Alan Blankley

Suzanne Blankley

5044