IREDELL COUNTY HEALTH DEPARTMENT

STATESVILLE 704-878-5305 MOORESVILLE 704-664-5281

IMPROVEMENT PERMIT / AUTHORIZATION TO CONSTRUCT / OPERATION PERMIT / EXISTING SYSTEM INSPECTION

PERMIT# 106057 / 128518 PIN# ~~4646-20-4611.78~~ 4646-28-7662 DATE 8/23/02

OWNER OR CONTRACTOR DIENST ENTERPRISES INC / Ryan Homes PHONE: Business 309-0123 Home

ADDRESS 19315 W. CATAWBA AVE SUITE 200 CORNELIUS NC 28031

LOCATION WILLIAMSON - TR SUNDOWN - TR SUNDOWN COVE - ON RT - CORNER OF CORONA

SUBDIVISION ESTATES @ SUNDOWN BLOCK / SECTION 2 LOT 78 LOT AREA 26115 SITE CLASS. RS DESIGN FLOW 450GPD L.T.A.R. .25 GPD/FT

Septic Tank: 1000 Gallons; STB 194 Date 11-8-05

Pump Tank: 1000 Gallons; PT 27 Date 11-9-05

Pump Make: Model Serial No.

Nitrification Field: No Fields 1 Square Feet 640 Linear Feet 320

No Lines 4 @ 80' Trench Width 24" Max Trench Bottom Depth 36" Gravel Depth N/A

☑ New System ☐ Repair System Type: I, II, III, IV, V, VI

System Description: LP PANEL

Repair System Description: SAME

Maintenance Agreement Required: ☑ Yes ☐ No

☐ House/Mod. Home ☐ Mobile Home ☐ Business ☐ Other

No. Bedrooms 4 No. Bathrooms 4 No. Employees

Water Supply: ☐ Individual ☐ Public ☑ Community


☐ Slab ☑ Crawl Space ☐ Basement w/plumbing ☐ Basement wo/plumbing

Comments/Conditions: 1) INLINE PUMP FILTER TO BE INSTALLED


Comments/Conditions: Checked tanks & lines 1/9/06
Pressure, float & alarm 1/25/06

1" = 50'

INITIAL SITE SKETCH

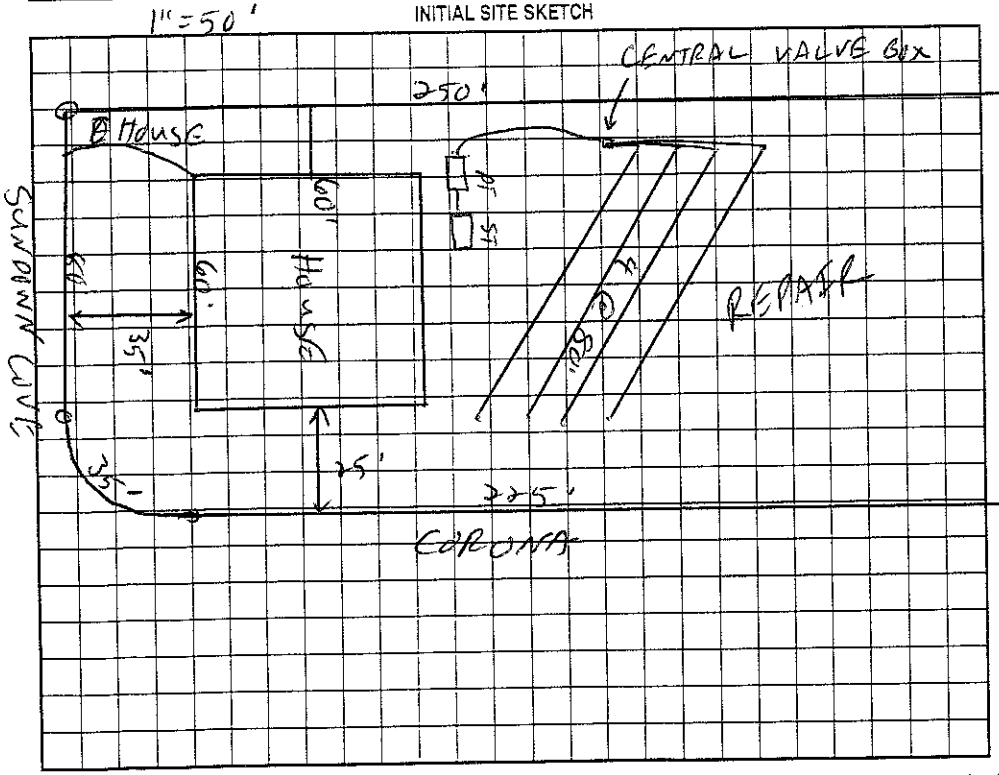

AS BUILT SKETCH

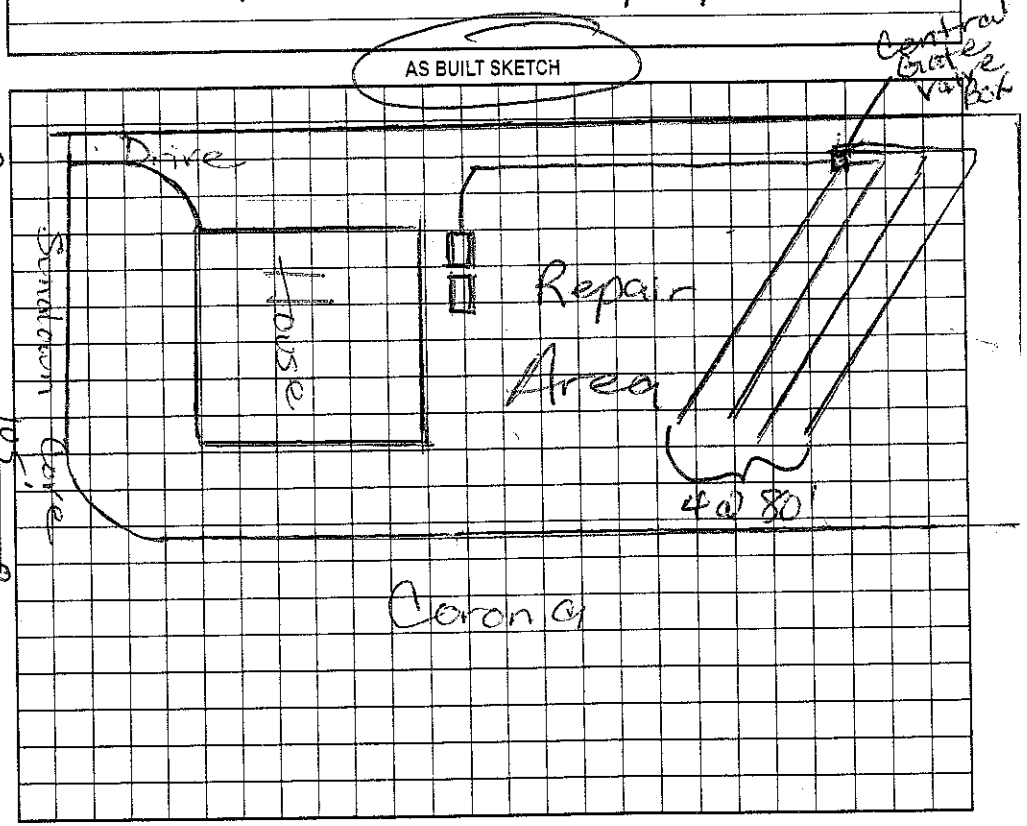

Permit can be suspended or revoked if any false information is supplied toward securing the permit/any unauthorized changes are made to the site/any unauthorized changes are made in the installation of the system. Improvement Permit with plat valid without expiration. Improvement Permit with site plan valid for sixty months. Authorization to Construct is valid for a period equal to that of Improvement Permit – not to exceed sixty months.

Signed: Robert B. Dienst date 9/20/02

Improvement Permit by: date 8/23/02

Authorization to Construct by: RS date 5/2/05

Installed by: R&H RS

Operation Permit by: date 1/25/06

Existing System Inspection by: date

HEALTH DEPT. COPY: WHITE OWNER COPY (FINAL): YELLOW OWNER COPY (INITIAL): PINK