IREDELL COUNTY HEALTH DEPARTMENT

STATESVILLE 704-878-5305 MOORESVILLE 704-664-5281

IMPROVEMENT PERMIT / AUTHORIZATION TO CONSTRUCT / OPERATION PERMIT / EXISTING SYSTEM INSPECTIO

PERMIT# 106028 PIN# ~~4646207611.4~~ 4646289068 DATE 8/28/02

OWNER OR CONTRACTOR DIENST ENTERPRISES / Ryan Homes PHONE: Business 309-0123 Home

ADDRESS 19315 W. CATAWBA AVE. CORNELIUS NC

LOCATION WILLIAMSON - TR SUNDOWN - TR SUNDOWN COVE - TL CORONA ON LT

SUBDIVISION ESTATES @ SUNDOWN BLOCK / SECTION LOT 4 LOT AREA 25740 SITE CLASS. PS DESIGN FLOW 480GPD L.T.A.R. .25000/FT

Septic Tank: 1000 Gallons; STB 794 Date 1/9/04
Pump Tank: 1000 Gallons; PT 285 Date 2/2/04
Pump Make: Myers Model ME=505-21 Serial No.
Nitrification Field: No Fields 1 Square Feet 640 Linear Feet 320
No Lines 5@64' Trench Width 24" Max Trench Bottom Depth 36" Gravel Depth N/A

☑ New System ☐ Repair System Type: I, II, III, IV, V, VI
System Description: LP PANEL
Repair System Description: SANE
Maintenance Agreement Required: ☑ Yes ☐ No

☑ House/Mod. Home No. Bedrooms 4
☐ Mobile Home No. Bathrooms 4
☐ Business No. Employees
☐ Other


☐ Slab ☑ Crawl Space ☐ Basement w/plumbing ☐ Basement wo/plumbing

Water Supply: ☐ Individual ☐ Public ☑ Community


Comments/Conditions: 1) INLINE PUMP FILTER TO BE INSTALLED
House will be 85' From Rd - Tank Location
May need to be adjusted

Comments/Conditions: Checked lines 5/12/04 MD
Checked pressure, elect & alarm 5/19/04 MD

INITIAL SITE SKETCH 1"=50'

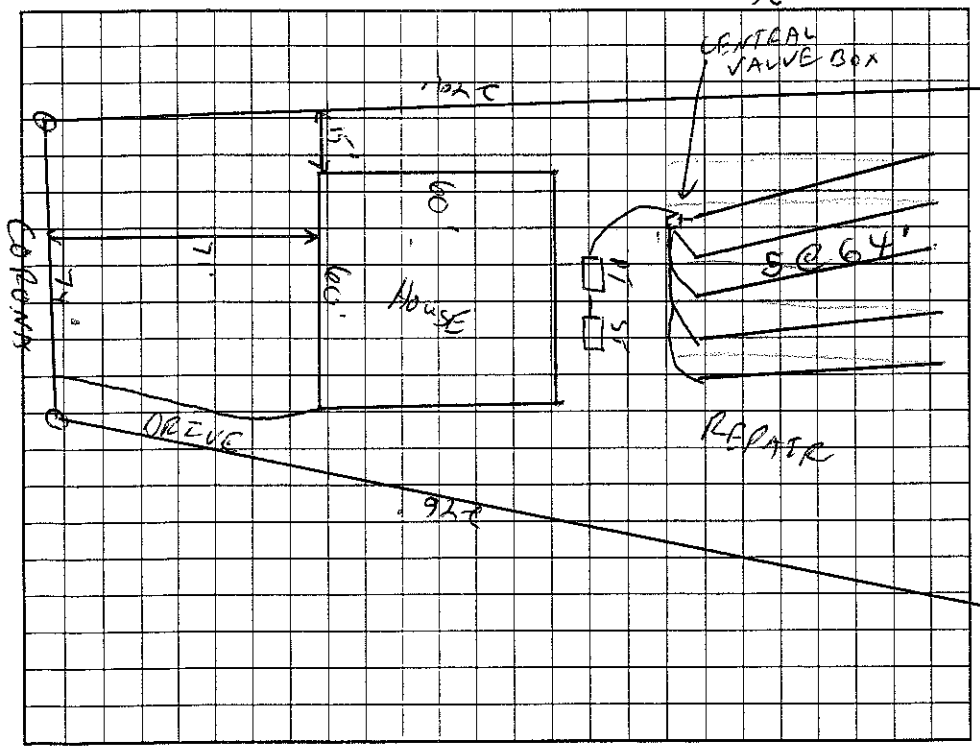

AS BUILT SKETCH

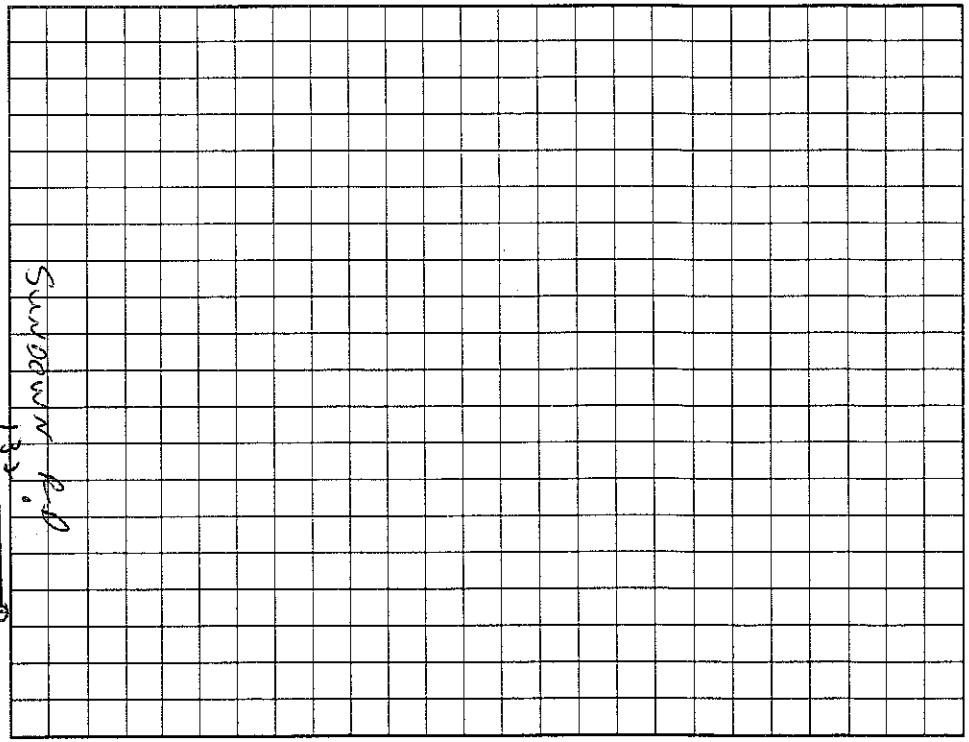

Permit can be suspended or revoked if any false information is supplied toward securing the permit/any unauthorized changes are made to the site/any unauthorized changes are made in the installation of the system. Improvement Permit with ~~plat~~ valid without expiration. Improvement ~~Permit with~~ site plan valid for sixty months. Authorization to Construct is valid for a period equal to that of Improvement Permit – not to exceed sixty months.

Signed: Robert B. Dienst date 9/20/02 Installed by: R+H RS

Improvement Permit by: RS date 8/28/02 Operation Permit by: RS date 5/21/04

Authorization to Construct by: LB date 2/10/04 Existing System Inspection by: date

HEALTH DEPT. COPY: WHITE OWNER COPY (FINAL): YELLOW OWNER COPY (INITIAL): PINK