IREDELL COUNTY HEALTH DEPARTMENT

STATESVILLE 704-878-5305 MOORESVILLE 704-664-5281

IMPROVEMENT PERMIT / AUTHORIZATION TO CONSTRUCT / OPERATION PERMIT / EXISTING SYSTEM INSPECTION

PERMIT# 105 992 PIN# ~~4646 20 46 11.57~~ 4646-28-9776 DATE 8/16/02

OWNER OR CONTRACTOR ~~DIGNT~~ DIGNST ENTERPRISES PHONE: Business 309-0123 Home

ADDRESS 19315 W. CATAWBA AVE. SUITE 200 CORNELIUS NC 28031

LOCATION WILLIAMSON - TR SUNDOWN RD - TR SUNDOWN COVE - TR CORONA - ON RT

SUBDIVISION ESTATES@SUNDOWN BLOCK / SECTION 1 LOT 57 LOT AREA 25000 ft² SITE CLASS. PS DESIGN FLOW 450GPD L.T.A.R. .2866/Ft

Septic Tank: 1000 Gallons; STB 794 Date 5-18-04
Pump Tank: 1000 Gallons; PT 27 Date 7-24-04
Pump Make: Myers Model ME50S-21 Serial No. 25325004
Nitrification Field: No Fields 1 Square Feet 840 Linear Feet 420
No Lines 6@70' Trench Width 24" Max Trench Bottom Depth 36" Gravel Depth N/A

☑ New System ☐ Repair System Type: I, II, III, IV, V, VI
System Description: LP PANEL
Repair System Description: SAME
Maintenance Agreement Required: ☑ Yes ☐ No


☑ House/Mod. Home No. Bedrooms 4
☐ Mobile Home No. Bathrooms 4
☐ Business No. Employees
☐ Other
☐ Slab ☑ Crawl Space ☐ Basement w/plumbing ☐ Basement wo/plumbing

Water Supply: ☐ Individual ☐ Public ☑ Community


Comments/Conditions: 1) INLINE PUMP FILTER TO BE INSTALLED

Comments/Conditions: Checked tanks & 4 of 6 lines (4 lower lines) 8/31/04 MD
Checked upper 2 lines 9/1/04
Checked pressure, elect & alarm 10/7/04

INITIAL SITE SKETCH 1"=50'

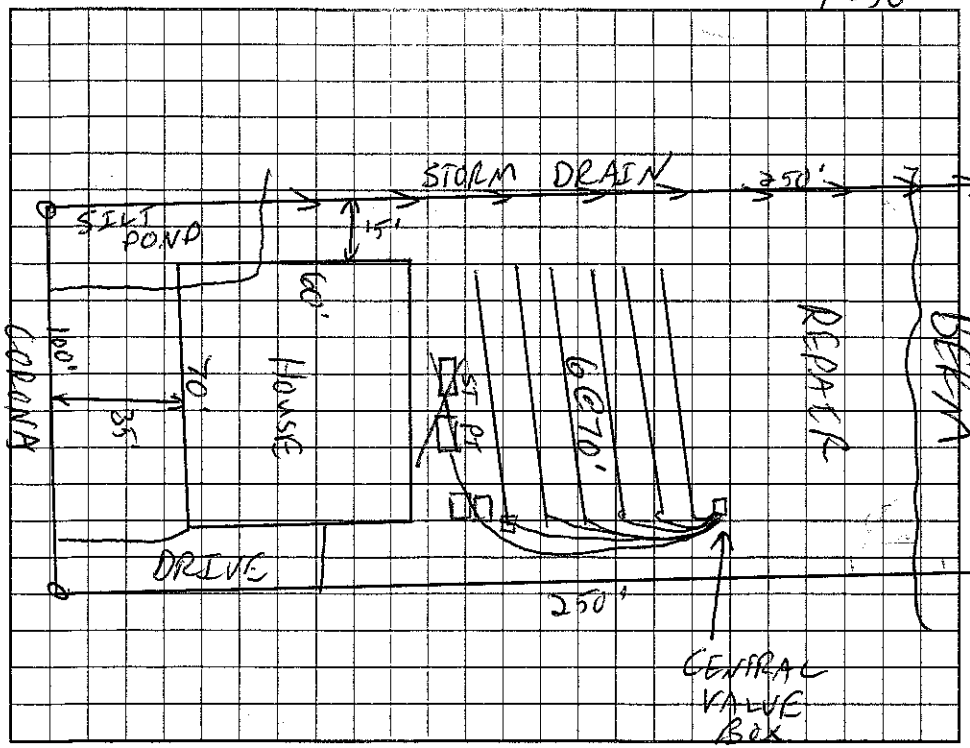

AS BUILT SKETCH

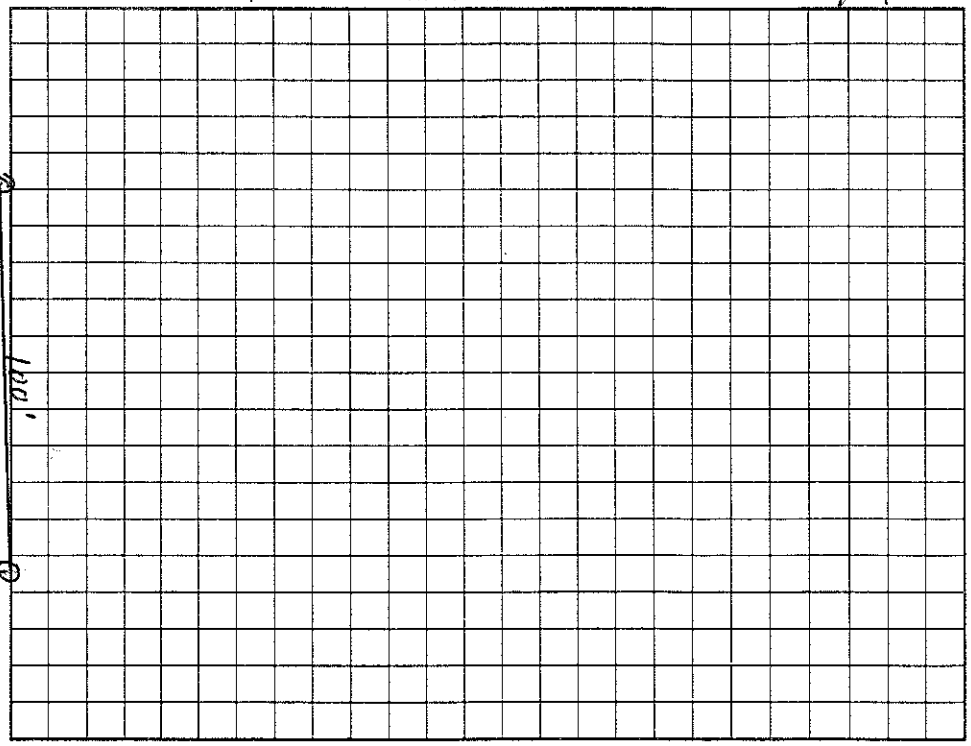

Permit can be suspended or revoked if any false information is supplied toward securing the permit/any unauthorized changes are made to the site/any unauthorized changes are made in the installation of the system. Improvement Permit with plat valid without expiration. Improvement Permit with site plan valid for sixty months. Authorization to Construct is valid for a period equal to that of Improvement Permit – not to exceed sixty months.

Signed: Robert B. Dignst date 9/20/02 Installed by: R & H

Improvement Permit by: C. [illegible] RS date 8/16/02 Operation Permit by: Maina H. Dotson RS date 10/11/04

Authorization to Construct by: W. Sparks RS date 7/12/04 Existing System Inspection by: date

HEALTH DEPT. COPY: WHITE OWNER COPY (FINAL): YELLOW OWNER COPY (INITIAL): PINK