IREDELL COUNTY HEALTH DEPARTMENT

STATESVILLE 704-878-5305 MOORESVILLE 704-664-5281

IMPROVEMENT PERMIT / AUTHORIZATION TO CONSTRUCT / OPERATION PERMIT / EXISTING SYSTEM INSPECTION

PERMIT# 105991 PIN# ~~4646-20-6111.56~~ 4646-28-9896 DATE 8/16/02

OWNER OR CONTRACTOR DIENST ENTERPRISES / Ryan Homes PHONE: Business 309-0123 Home

ADDRESS 19315 W. CATAWBA AVE. SUITE 200 CORNELIUS NC 28031

LOCATION WILLIAMSON - JR SUNDOWN - JR SUNDOWN COVE - JR CORONA - ON RT

SUBDIVISION ESTATES @ SUNDOWN BLOCK / SECTION 1 LOT 56 LOT AREA 25,000 sf+- SITE CLASS. RS DESIGN FLOW 360 GPD L.T.A.R. .2 gpd/sf

Septic Tank: 1000 Gallons; STB 794 Date 5/2/05

Pump Tank: 1000 Gallons; PT 283 Date 4/30/05

Pump Make Goulds Model _____ Serial No. _____

Nitrification Field: No Fields 1 Square Feet 600 Linear Feet 300

No Lines 5@60' Trench Width 24" Max Trench Bottom Depth 36" Gravel Depth NA

☑ New System ☐ Repair System Type: I, II, III, (IV) V, VI

System Description: LP PANEL

Repair System Description: SAME

Maintenance Agreement Required: ☑ Yes ☐ No

☑ House/Mod. Home No. Bedrooms 3

☐ Mobile Home No. Bathrooms 3

☐ Business No. Employees ____

☐ Other ____


☐ Slab ☑ Crawl Space ☐ Basement w/plumbing ☐ Basement wo/plumbing

Water Supply: ☐ Individual ☐ Public ☑ ~~Community~~


Comments/Conditions: 1) INLINE PUMP FILTER TO BE INSTALLED

Comments/Conditions: Lines & tanks Checked 6/8/05 by GR
65 gpm 5 3/16" holes
Checked Pressure, elect & alarm 7/12/05

INITIAL SITE SKETCH 1"=50'

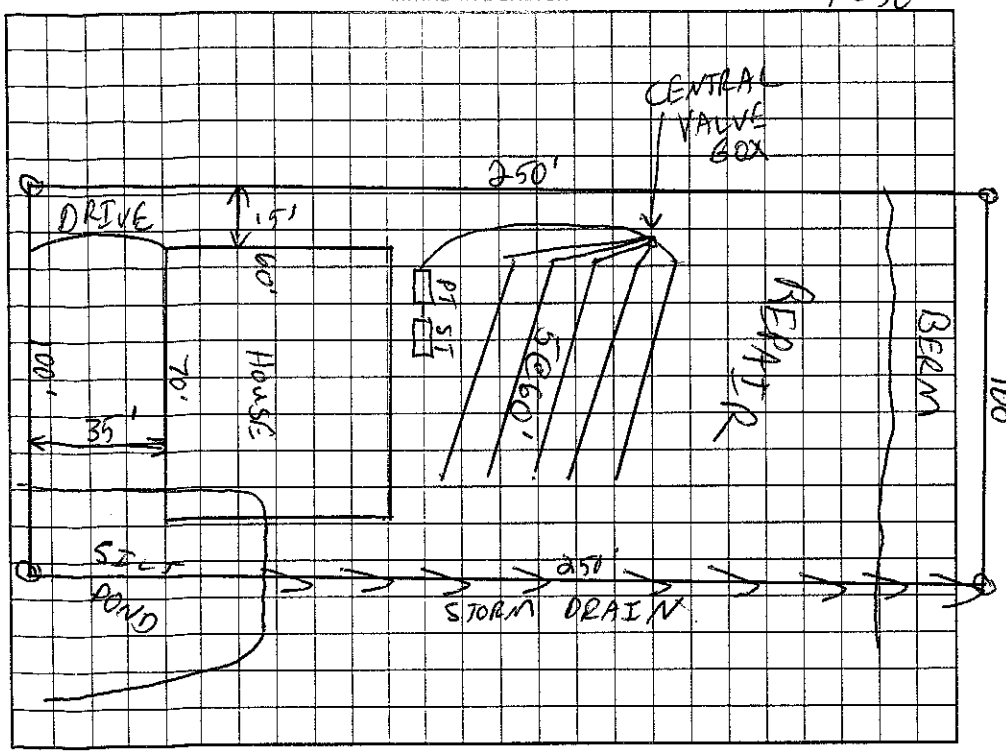

AS BUILT SKETCH

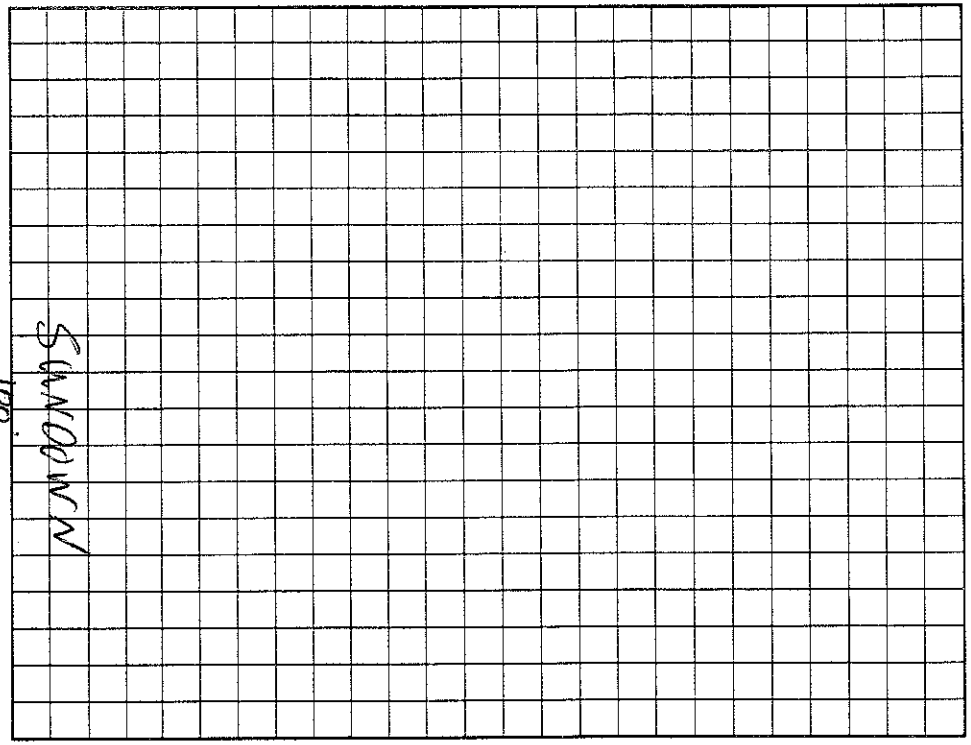

Permit can be suspended or revoked if any false information is supplied toward securing the permit/any unauthorized changes are made to the site/any unauthorized changes are made in the installation of the system. Improvement Permit with plat valid without expiration. Improvement Permit with site plan valid for sixty months. Authorization to Construct is valid for a period equal to that of Improvement Permit – not to exceed sixty months.

Signed: Robert B. Dienst date 9/20/02

Improvement Permit by: C. [illegible] RS date 8/16/02

Authorization to Construct by: [illegible] RS date 3/30/05

Installed by: R+H Dolan RS

Operation Permit by: Dolan RS date 7/13/05

Existing System Inspection by: _____ date _____

HEALTH DEPT. COPY: WHITE OWNER COPY (FINAL): YELLOW OWNER COPY (INITIAL): PINK