IREDELL COUNTY HEALTH DEPARTMENT

STATESVILLE 704-878-5305 MOORESVILLE 704-664-5281

IMPROVEMENT PERMIT / AUTHORIZATION TO CONSTRUCT / OPERATION PERMIT / EXISTING SYSTEM INSPECTION

PERMIT# 105990 PIN# ~~4646 20 8611 55~~ 4646-28-9996 DATE 8/16/02

OWNER OR CONTRACTOR DIENST ENTERPRISES / Ryan Homes PHONE: Business 309-0123 Home

ADDRESS 19315 W. CATAWBA AVE. SUITE 200 CORNELIUS NC 28031

LOCATION WILLIAMSON - IR SUNDOWN - IR SUNDOWN COVE - IR CORONA - ON RT #123

SUBDIVISION ESTATES@SUNDOWN BLOCK / SECTION 1 LOT 55 LOT AREA 25,000ft² SITE CLASS. RS DESIGN FLOW 360GPD L.T.A.R. , @GPD/ft²

Septic Tank: 1000 Gallons; STB 794 Date 1-13-06
Pump Tank: 1000 Gallons; PT 3 Date 10-17-05
Pump Make: _____ Model _____ Serial No. _____
Nitrification Field: No Fields 1 Square Feet 600 Linear Feet 300
No Lines 5@60' Trench Width 24" Max Trench Bottom Depth 36" Gravel Depth N/A

☑ New System ☐ Repair System Type: I, II, III, (IV), V, VI
System Description: LPP PANEL
Repair System Description: SAME
Maintenance Agreement Required: ☑ Yes ☐ No


☑ ~~House~~/Mod. Home No. Bedrooms 3
☐ Mobile Home No. Bathrooms 3
☐ Business No. Employees ____
☐ Other _____
☐ Slab ☐ ~~Crawl Space~~ ☐ Basement w/plumbing ☐ Basement wo/plumbing

Water Supply:
☐ Individual
☐ Public
☑ ~~Community~~


Comments:/Conditions: 1) INLINE PUMP FILTER TO BE INSTALLED

Comments:/Conditions: Checked tanks & lines 2/15 & 2/16/06 (Installed intial system in repair area)

INITIAL SITE SKETCH 1"=50'

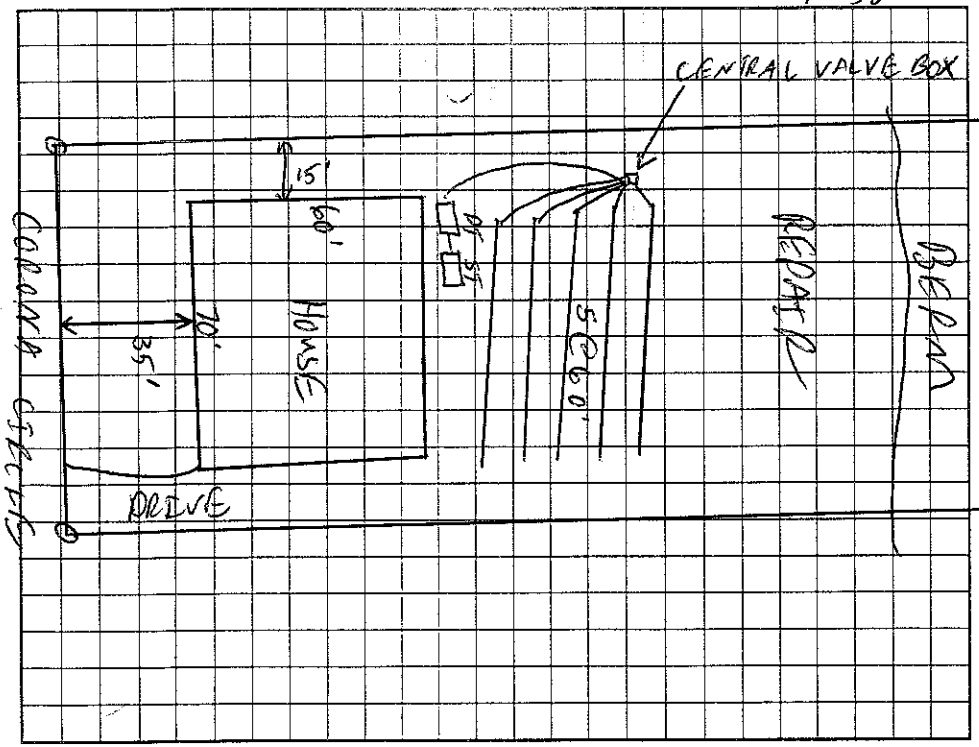

AS BUILT SKETCH

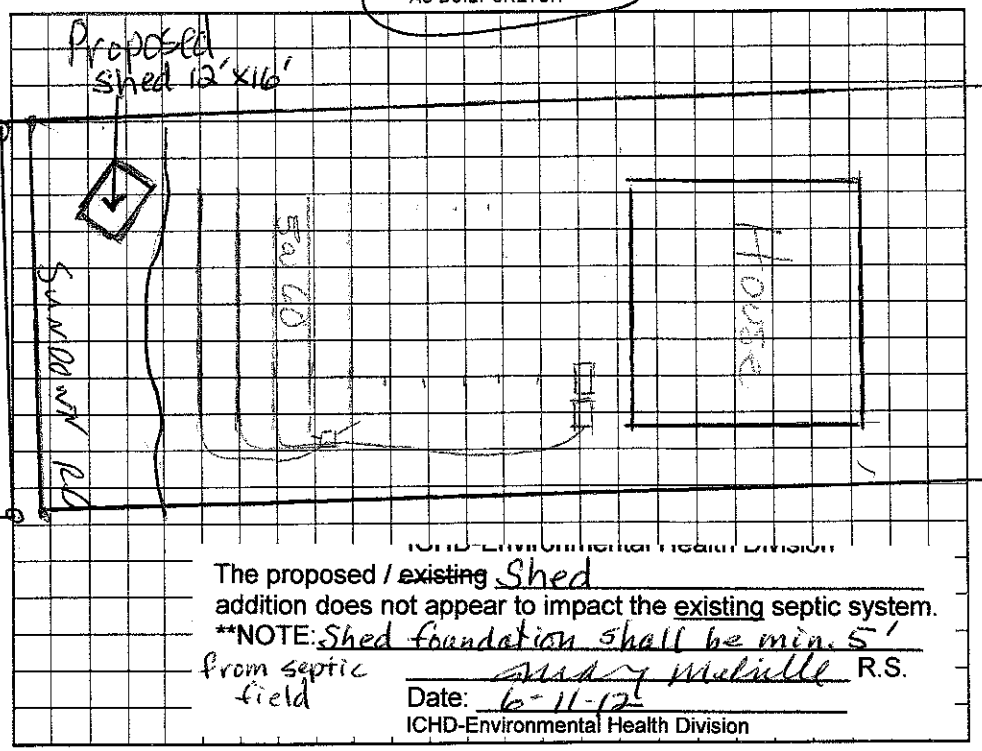

ICHD-Environmental Health Division

The proposed / ~~existing~~ Shed addition does not appear to impact the existing septic system.

**NOTE: Shed foundation shall be min. 5' from septic field

Mindy Melville R.S.

Date: 6-11-12

ICHD-Environmental Health Division

Permit can be suspended or revoked if any false information is supplied toward securing the permit/any unauthorized changes are made to the site/any unauthorized changes are made in the installation of the system. Improvement Permit with plat valid without expiration; Improvement Permit with site plan valid for sixty months. Authorization to Construct is valid for a period equal to that of Improvement Permit – not to exceed sixty months.

Signed: Robert B. Dienst date 9/20/02

Improvement Permit by: RS date 8/16/02

Authorization to Construct by: RS date 11/22/05

Installed by: R & H

Operation Permit by: RS date 3/1/06

Existing System Inspection by: _____ date _____

HEALTH DEPT. COPY: WHITE OWNER COPY (FINAL): YELLOW OWNER COPY (INITIAL): PINK