IREDELL COUNTY HEALTH DEPARTMENT

STATESVILLE 704-878-5305 MOORESVILLE 704-664-5281

IMPROVEMENT PERMIT / AUTHORIZATION TO CONSTRUCT / OPERATION PERMIT / EXISTING SYSTEM INSPECTION

PERMIT# 105990 PIN# ~~4646-20-4611-55~~ 4646-28-9996 DATE 8/16/02

OWNER OR CONTRACTOR DIENST ENTERPRISES / Ryan Homes PHONE: Business 309-0183 Home

ADDRESS 19315 W. CATAWBA AVE SUITE 200 CORNELIUS NC 28031

LOCATION WILLIAMSON - TR SUNDOWN - TR SUNDOWN COVE - TR CORONA - ON RT #123

SUBDIVISION ESTATES@SUNDOWN BLOCK / SECTION 1 LOT 55 LOT AREA 25,000ft2 SITE CLASS. RS DESIGN FLOW 360GPD L.T.A.R. .2GPD/FT2

Septic Tank: 1000 Gallons; STB 794 Date 1-13-06

Pump Tank: 1000 Gallons; PT 21 Date 10-17-05

Pump Make: Model Serial No.

Nitrification Field: No Fields 1 Square Feet 600 Linear Feet 300

No Lines 5@60' Trench Width 24" Max Trench Bottom Depth 36" Gravel Depth N/A

☑ New System ☐ Repair System Type: I, II, III, IV, V, VI

System Description: LPP PANEL

Repair System Description: SAME

Maintenance Agreement Required: ☑ Yes ☐ No

☑ House/Mod. Home No. Bedrooms 3

☐ Mobile Home No. Bathrooms 3

☐ Business No. Employees

☐ Other


☐ Slab ☑ Crawl Space ☐ Basement w/plumbing ☐ Basement wo/plumbing

Water Supply: ☐ Individual ☐ Public ☑ Community


Comments:/Conditions: 1) INLINE PUMP FILTER TO BE INSTALLED

Comments:/Conditions: Checked tanks & lines 2/15 & 2/16/ (Installed intial system in repair area)

INITIAL SITE SKETCH 1"=50'

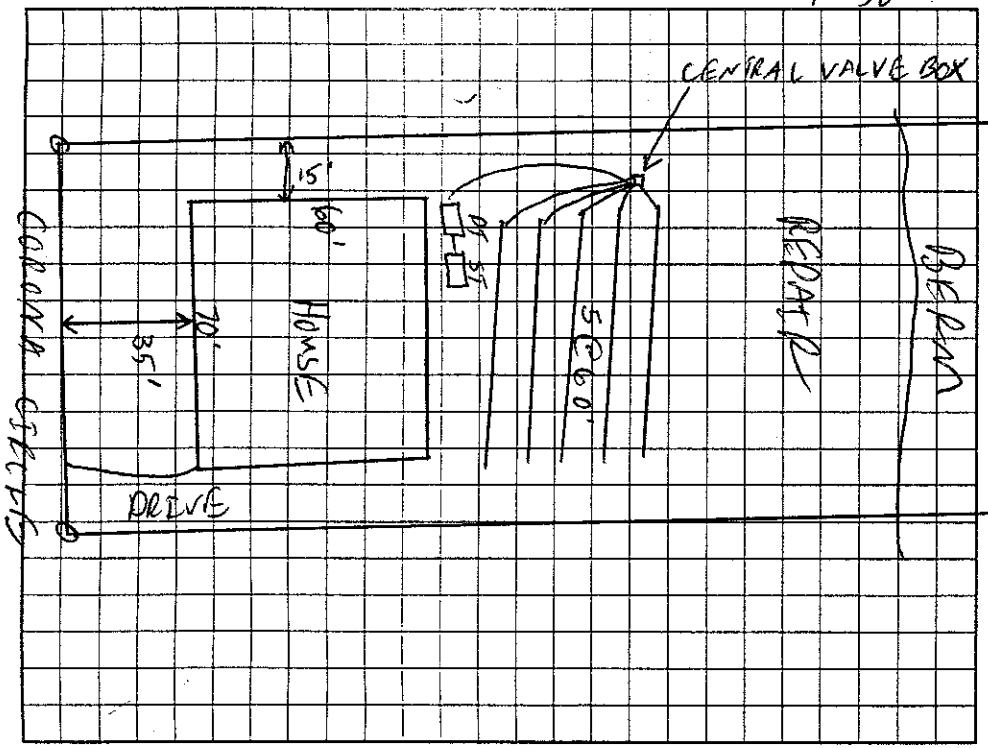

AS BUILT SKETCH

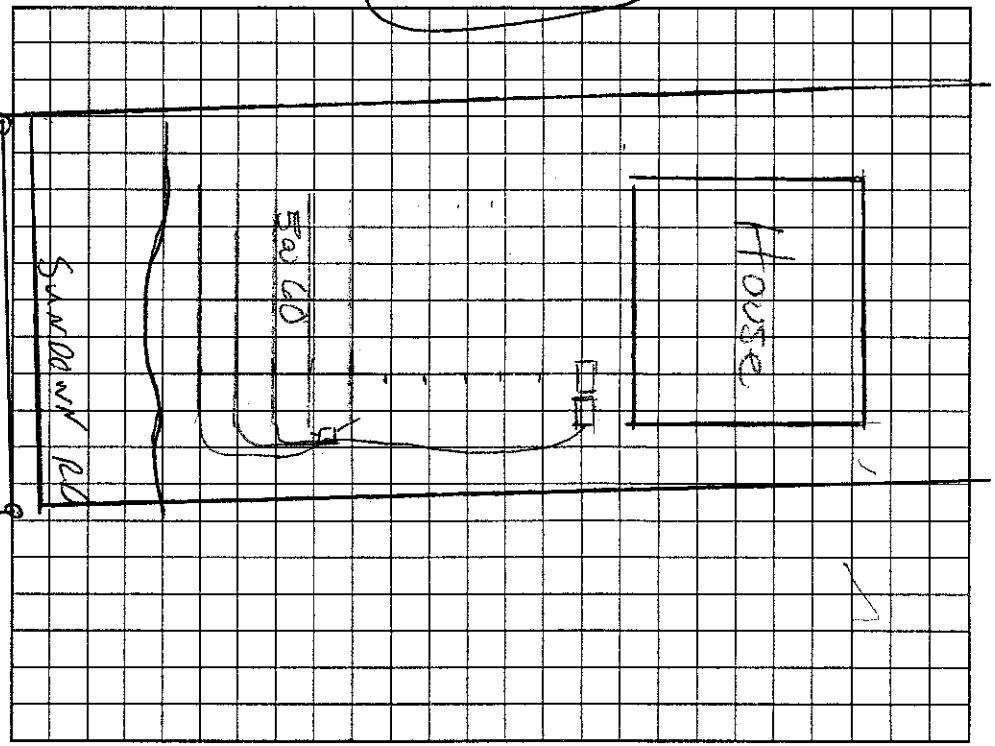

Permit can be suspended or revoked if any false information is supplied toward securing the permit/any unauthorized changes are made to the site/any unauthorized changes are made in the installation of the system. Improvement Permit with plat valid without expiration. Improvement Permit with site plan valid for sixty months. Authorization to Construct is valid for a period equal to that of Improvement Permit – not to exceed sixty months.

Signed: Robert B. Dienst date 9/20/02 Installed by: R & H

Improvement Permit by: RS date 8/16/02 Operation Permit by: RS date 3/1/06

Authorization to Construct by: RS date 11/22/05 Existing System Inspection by: date

HEALTH DEPT. COPY: WHITE OWNER COPY (FINAL): YELLOW OWNER COPY (INITIAL): PINK