# IREDELL COUNTY HEALTH DEPARTMENT

AUTHORIZATION TO CONSTRUCT

STATESVILLE 704-878-5305 MOORESVILLE 704-664-5281

## IMPROVEMENT PERMIT / ~~CERTIFICATE OF COMPLETION~~ / OPERATION PERMIT / EXISTING SYSTEM INSPECTION

PROPERTY DESCRIPTION NO. 234 24 DATE 6/13/97 TAX MAP NO. 2K-27-A-19 4646291746 Watershed: ☑ Yes ☐ No

OWNER OR CONTRACTOR TIM PERRY PHONE: Business _____ Home 662-0270

ADDRESS 218 DOOLIE RD MOORESVILLE NC 28115

LOCATION BRAWLEY SCHOOL RD - TL FARMSTEAD - AT END ON LEFT IN CUL-DE-SAC

SUBDIVISION FARMSTEAD BLOCK / SECTION II LOT 55 LOT AREA ≈1.0 AC SITE CLASS. PS DESIGN FLOW 360GD L.T.A.R. .36GPD/FT²

Septic Tank: 1000 Gallons; STB 1012 Date 6/31/97

Pump Tank: 1000 Gallons; PT 17 Date 6/30/97

Pump Make: _____ Model _____ Serial No. _____

Nitrification Field: No Fields 1 Square Feet 1200 Linear Feet 400

No Lines 4 @ 100' Trench Width 36" Max Trench Bottom Depth 24" Gravel Depth 12"

☑ New System ☐ Repair System Type: I, II, ☑ III, IV, V, VI

System Description: PUMP SHALLOW CONVENTIONAL

Repair System Description: PUMP CHAMBERED OR EQUIV.

Maintenance Agreement Required: ☐ Yes ☑ No

☑ House/Mod. Home No. Bedrooms 3

☐ Mobile Home No. Bathrooms 2

☐ Business No. Employees ____

☐ Other _____

☐ Slab ☑ Crawl Space ☐ Basement w/plumbing ☐ Basement wo/plumbing


Water Supply: ☑ Individual ☐ Community ☐ Public

Comments:


Comments: LINES, TANKS 9/8/97

1"=50'

INITIAL SITE SKETCH

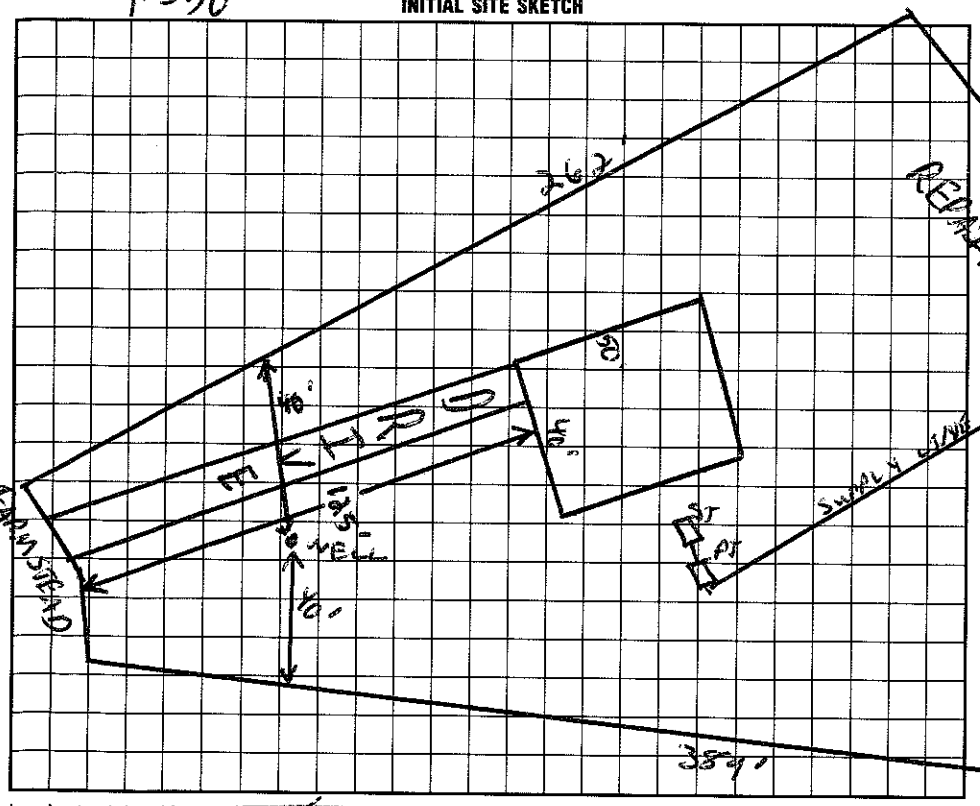


AS BUILT SKETCH

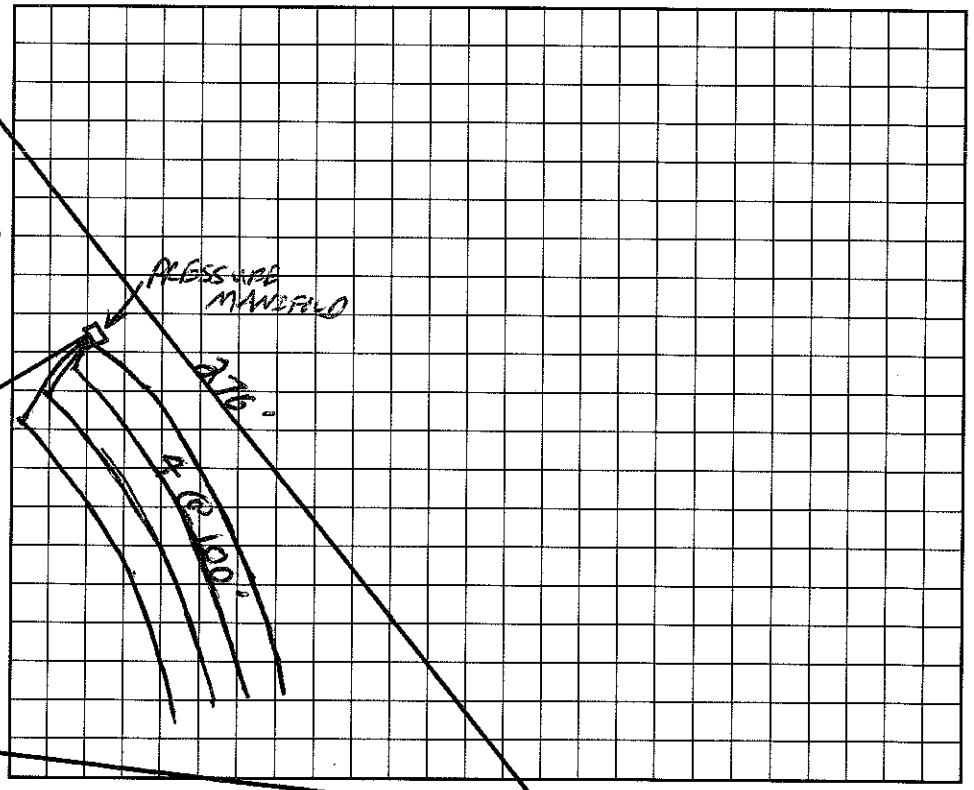


I understand that this permit can be suspended or revoked if any false information is supplied toward securing the permit/any unauthorized changes are made to the site/any unauthorized changes are made in the installation of the system. Improvement Permit is valid for 60 months from date of issuance.

Signed: _____

Installed by: ABERNATHY

Improvement Permit by: C. Ray Teer date 6/13/97

AUTHORIZATION TO CONSTRUCT

~~Existing System Inspection by:~~ C. Ray Teer date 6/13/97

Certificate of Completion by: _____ date _____

Operation Permit by: C. Ray Teer date 11/17/97

~~HEALTH DEPT. COPY: WHITE~~ ~~INSPECTION COPY (FINAL): GREEN~~ OWNER COPY (FINAL): YELLOW INSPECTION COPY (INITIAL): PINK OWNER COPY (INITIAL): GOLD