4100 10.30

IREDELL COUNTY HEALTH DEPARTMENT

STATESVILLE 704-878-5305 MOORESVILLE 704-664-5281

IMPROVEMENT PERMIT / AUTHORIZATION TO CONSTRUCT / OPERATION PERMIT / EXISTING SYSTEM INSPECTION

PERMIT# 108573 PIN# 4646 28 4611.25 4646293178 DATE 10/17/02

OWNER OR CONTRACTOR DIENST ENTERPRISES / Ryan Homes PHONE: Business 309-0103 Home

ADDRESS 125 EASTON DRIVE - MOORESVILLE NC 28117

LOCATION WILLIAMSON - TR SUNDOWN - TR SUNDOWN COVE - TR CORONA - TL CORONA - CT

SUBDIVISION ESTATES @ SUNDOWN BLOCK / SECTION LOT 25 LOT AREA ~27650 ft² SITE CLASS. RS DESIGN FLOW 480GPD L.T.A.R. .36GPD/FT²

Septic Tank: 1000 Gallons; STB 799 Date 8/6/05

Pump Tank: 1000 Gallons; PT 283 Date 4/2/06

Pump Make: Goulds Model WED312M Serial No.

Nitrification Field: No Fields 1 Square Feet 1200 Linear Feet 400

No Lines 4 @ 100' Trench Width 36" Max Trench Bottom Depth 36" Gravel Depth N/A

☑ New System ☐ Repair System Type: I, II, III, IV, V, VI

System Description: PUMP INNOVATIVE

Repair System Description: LP PANEL

Maintenance Agreement Required: ☐ Yes ☑ No

☑ House/Mod. Home ☐ Mobile Home ☐ Business ☐ Other

No. Bedrooms 4 No. Bathrooms 4 No. Employees


☐ Slab ☑ Crawl Space ☐ Basement w/plumbing ☐ Basement wo/plumbing

Water Supply: ☐ Individual ☐ Public ☑ Community


Comments/Conditions: Drive on other side

Comments/Conditions: Checked tanks & lines 5/19/06. Pressure, elect & alarm 6/19/06

INITIAL SITE SKETCH 1" = 50'

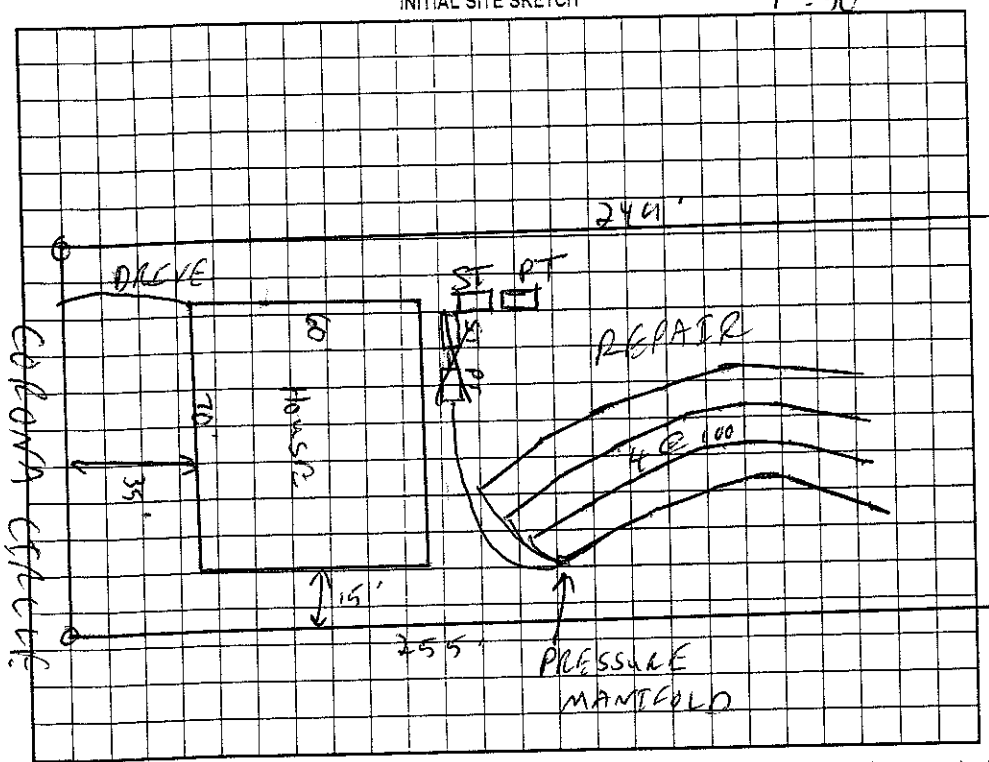

AS BUILT SKETCH

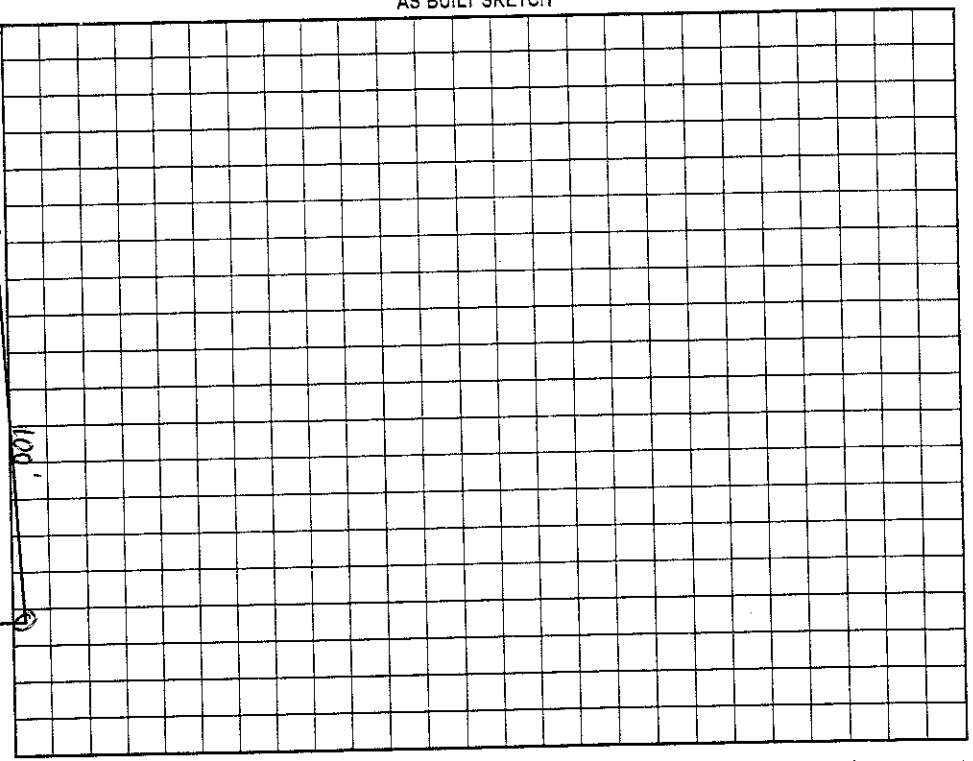

Permit can be suspended or revoked if any false information is supplied toward securing the permit/any unauthorized changes are made to the site/any unauthorized changes are made in the installation of the system. Improvement Permit with plat valid without expiration. Improvement Permit with site plan valid for sixty months. Authorization to Construct is valid for a period equal to that of Improvement Permit – not to exceed sixty months.

Signed: Robert R. Dienst date 11/27/02

Improvement Permit by: RS date 10/17/02

Authorization to Construct by: RS date 1/3/06

Installed by: RS date 6/19/06

Operation Permit by: date

Existing System Inspection by: date

HEALTH DEPT. COPY: WHITE OWNER COPY (FINAL): YELLOW OWNER COPY (INITIAL): PINK