100.00 Paid 4:00

IREDELL COUNTY HEALTH DEPARTMENT

STATESVILLE 704-878-5305 MOORESVILLE 704-664-5281

IMPROVEMENT PERMIT / AUTHORIZATION TO CONSTRUCT / OPERATION PERMIT / EXISTING SYSTEM INSPECTION

PERMIT# 122215 PIN# ~~4646-28-4641-31~~ 4646296430 DATE 1/16/06

OWNER OR APPLICANT Ryan Homes PHONE: Business 704 875-9087 Home

ADDRESS 9920 Kincey Ave. #110 Huntersville NC 28078

LOCATION Williamson to Sundown, TR Eclipse Way, on LT

SUBDIVISION Est. @ Sundown BLOCK / SECTION 3 LOT 31 LOT AREA 1.64 Ac SITE CLASS. A5 DESIGN FLOW 480 L.T.A.R. 0.225

Septic Tank: 1000 Gallons; STB 794 Date 5-5-06
Pump Tank: 1000 Gallons; PT 37 Date 5-2-06
Pump Make: Myers Model ME50 Serial No.
Nitrification Field: No. Fields 1 Square Feet 720 Linear Feet 360
No. Lines 4 Trench Width 24" Max Trench Bottom Depth 36"

☒ New System ☐ Repair ☐ Expansion System Type: I, II, III, (IV), V, VI
System Description: LP Panel Block
Repair System Description: Same
Maintenance Agreement Required: ☒ Yes ☐ No

☒ House/Mod. Home ☐ Mobile Home ☐ Business ☐ Other
No. Bedrooms 4 No. Persons ___ No. Employees ___

Water Supply: ☐ Individual ☐ Public ☒ Community


Gravel Depth — ☐ Gravity ☒ Pressure ☐ Slab ☒ Crawl Space ☐ Basement w/plumbing ☐ Basement wo/plumbing

Comments:/Conditions:

Comments:/Conditions: Checked tanks & lines 6/9/06


1" = 50'

INITIAL SITE SKETCH

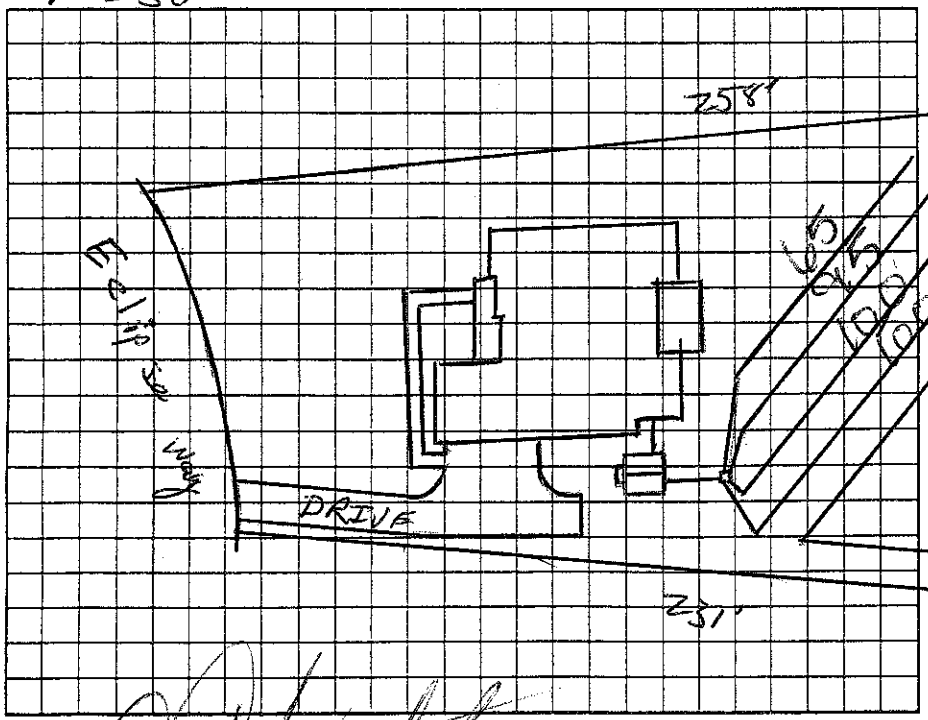

AS BUILT SKETCH

Installed essentially as Drawn

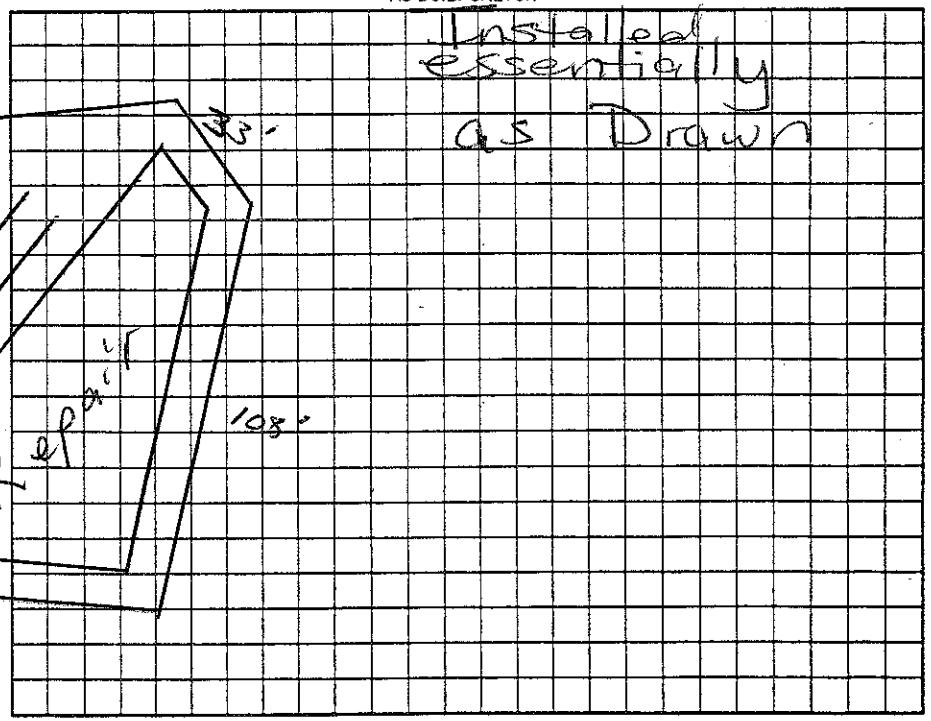

Permit can be suspended or revoked if any false information is supplied toward securing the permit/any unauthorized changes are made to the site/any unauthorized changes are made in the installation of the system. Improvement Permit with plat valid without expiration ☐ Improvement Permit with site plan valid for sixty months ☒ Authorization to Construct is valid for a period equal to that of Improvement Permit – not to exceed sixty months.

Signed: date 1/16/06

Improvement Permit by: date 1/11/06

Authorization to Construct by: date 1/11/06

Installed by: R&H date

Operation Permit by: Marion H. Dotson RS date 6/23/06

Existing System Inspection by: date

HEALTH DEPT COPY: WHITE OWNER COPY (FINAL): YELLOW OWNER COPY (INITIAL): PINK