IREDELL COUNTY HEALTH DEPARTMENT

STATESVILLE 704-878-5305 MOORESVILLE 704-664-5281

IMPROVEMENT PERMIT / AUTHORIZATION TO CONSTRUCT / OPERATION PERMIT / EXISTING SYSTEM INSPECTION

PERMIT# 105585 PIN# ~~4646 26 46 11.29~~ 4646297177.000 DATE 10/15/02

OWNER OR CONTRACTOR DIENST ENTERPRISES / RYAN HOMES PHONE: Business 309-0123 Home

ADDRESS 125 EASTON DR. MOORESVILLE NC 28117

LOCATION WILLIAMSON - TR SUNDOWN - TR SUNDOWN COVE - TR CORONA CIRCLE - TL CORONA - ON RT CORNER

SUBDIVISION ESTATES @ SUNDOWN BLOCK / SECTION LOT 29 LOT AREA 25650 ft² SITE CLASS. PS DESIGN FLOW 480 GPD L.T.A.R. .256 GPD/FT²

Septic Tank: 1000 Gallons; STB 312 Date 3-2-04

Pump Tank: 1000 Gallons; PT 283 Date 6-20-05

Pump Make: Model Serial No.

Nitrification Field: No Fields 1 Square Feet 1440 Linear Feet 480

No Lines 6 @ 80' Trench Width 36" Max Trench Bottom Depth 36" Gravel Depth N/A

☑ New System ☐ Repair System Type: I, II, (III) IV, V, VI

System Description: PUMP 25% REDUCTION

Repair System Description: LP PANEL

Maintenance Agreement Required: ☐ Yes ☑ No

☑ House/Mod. Home ☐ Mobile Home ☐ Business ☐ Other

No. Bedrooms 4 No. Bathrooms 4 No. Employees

☐ Slab ☑ Crawl Space ☐ Basement w/plumbing ☐ Basement wo/plumbing

Water Supply: ☐ Individual ☐ Public ☑ Community


Comments:/Conditions:

Comments:/Conditions: Checked tanks 7/26/05 mb


Checked lines 8/4/05 mb

Pressure relief & alarm 9/16/05

INITIAL SITE SKETCH 1"=50'

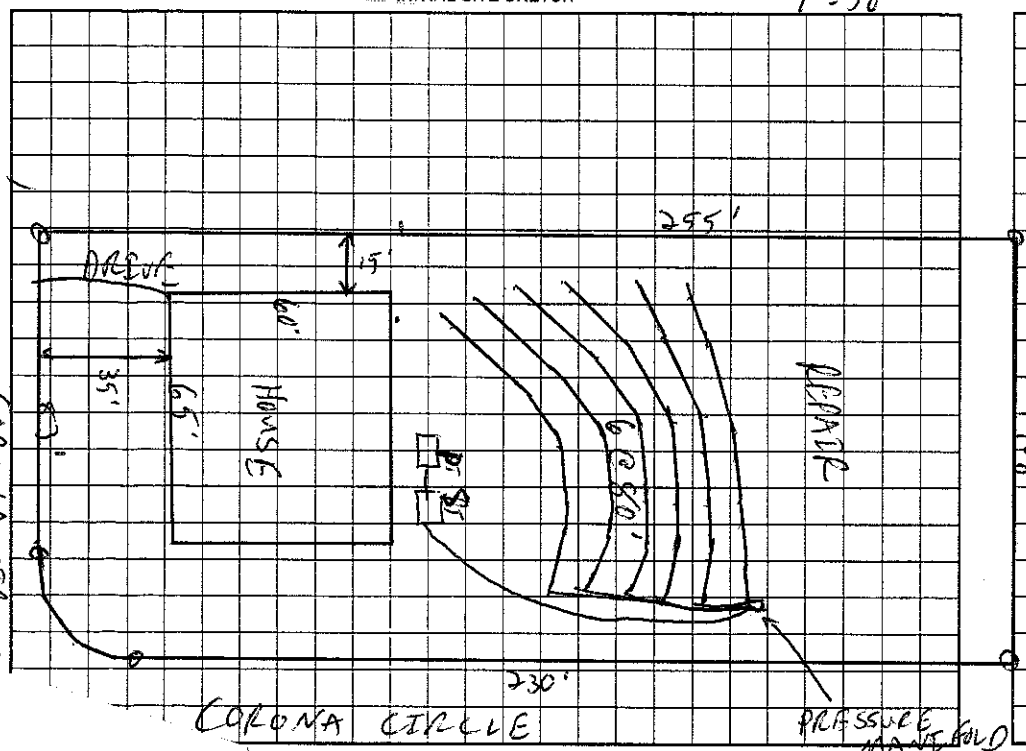

AS BUILT SKETCH

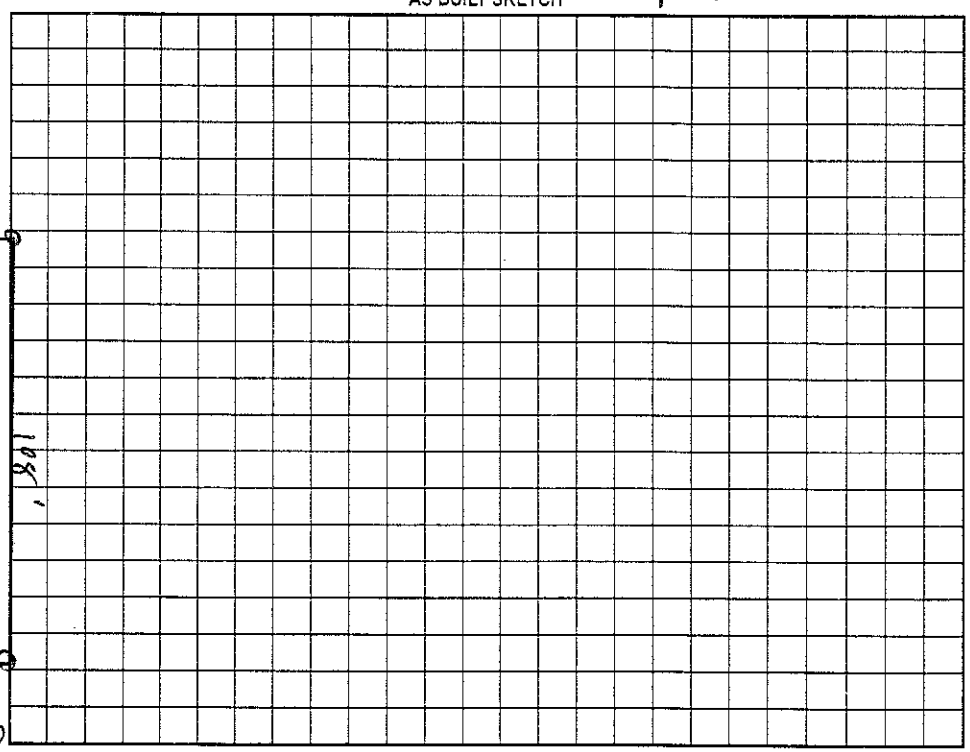

revoked if any false information is supplied toward securing the permit/any unauthorized changes are made to the site/any unauthorized changes are made in the installation of the system. Improvement expiration. Improvement Permit with site plan valid for sixty months. Authorization to Construct is valid for a period equal to that of Improvement Permit – not to exceed sixty months.

HD, Dienst date 11-7-02 Installed by: R & H Dolan RS

RS date 10/15/02 Operation Permit by: Mark H Dolan date 9/16/05

ct by: CO RS date 5/5/05 Existing System Inspection by: date

HEALTH DEPT. COPY: WHITE OWNER COPY (FINAL): YELLOW OWNER COPY (INITIAL): PINK