IREDELL COUNTY HEALTH DEPARTMENT

STATESVILLE 704-878-5305 MOORESVILLE 704-664-5281

800.00 Paid 3:00

IMPROVEMENT PERMIT / AUTHORIZATION TO CONSTRUCT / OPERATION PERMIT / EXISTING SYSTEM INSPECTION

PERMIT# 122249 PIN# ~~4646-28-4611.45~~ 4646297839 DATE 2-10-06

OWNER OR APPLICANT NVR, Inc. / Ryan Homes PHONE: Business 704-875-9887 Home

ADDRESS 9920 Kincey Ave #110 Huntersville 28078

LOCATION Brawley School Rd TL Williamson TR Sundown TR Eclipse on Right

SUBDIVISION Estates @ Sundown BLOCK / SECTION 3 LOT 45 LOT AREA .64 Ac SITE CLASS. PS DESIGN FLOW 480gpd L.T.A.R. .25 gpd/ft²

Septic Tank: 1000 Gallons: STB 794 Date 4-4-06

Pump Tank: 1000 Gallons: PT 283 Date 3-17-06

Pump Make: Myers Model ME50521 Serial No. 1/2 horse 07

Nitrification Field: No Fields 1 Square Feet 1920 Linear Feet 320

No Lines 5 Trench Width 24" Max Trench Bottom Depth 36"

☒ New System ☐ Repair ☐ Expansion System Type: I II III IV V VI

System Description: LP Panel

Repair System Description: LP Panel

Maintenance Agreement Required: ☒ Yes ☐ No

☒ House/Mod. Home No. Bedrooms 4

☐ Mobile Home No. Persons

☐ Business No. Employees

☐ Other


Water Supply: ☐ Individual ☒ Public ☒ Community

Gravel Depth NA ☐ Gravity ☒ Pressure ☐ Slab ☒ Crawl Space ☐ Basement w/plumbing ☐ Basement wo/plumbing


Comments:/Conditions: 74 panels
Water line is not to cross repair area

Comments:/Conditions:
White poly lok filter
blue
9 ft w/ risers

1" = 40' INITIAL SITE SKETCH 180, 36'

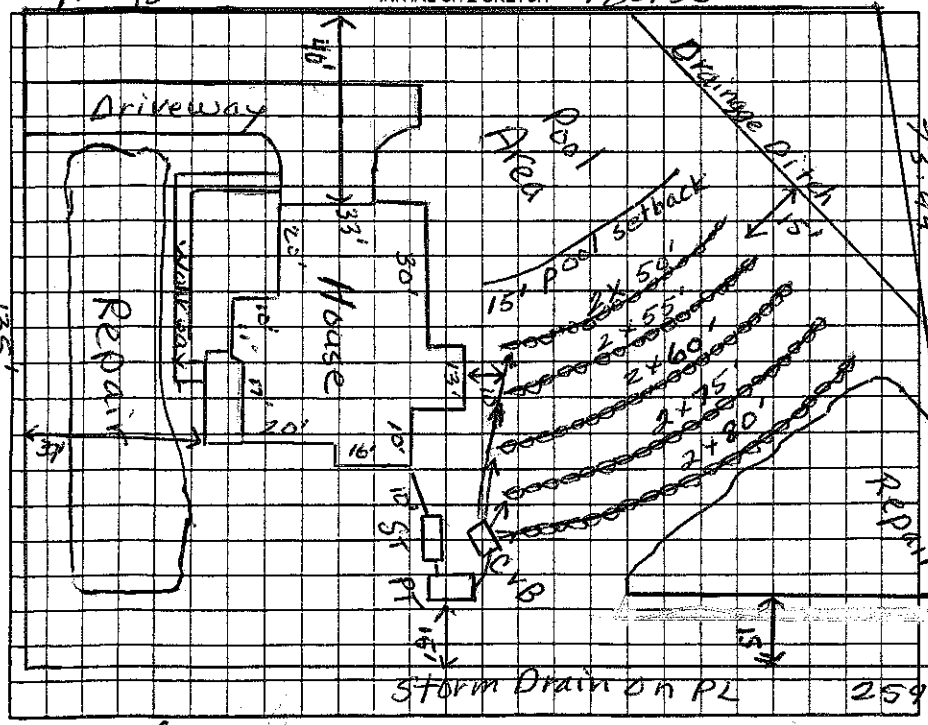

AS BUILT SKETCH

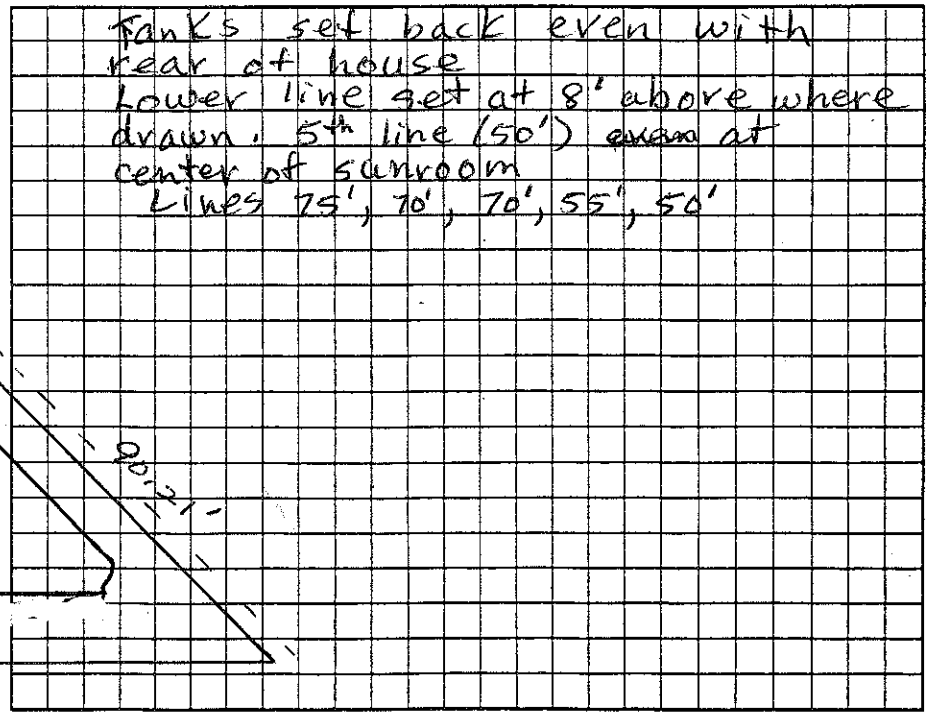

Permit can be suspended or revoked if any false information is supplied toward securing the permit/any unauthorized changes are made to the site/any unauthorized changes are made in the installation of the system. Improvement Permit with plat valid without expiration ☐ Improvement Permit with site plan valid for sixty months ☒ Authorization to Construct is valid for a period equal to that of Improvement Permit – not to exceed sixty months.

Signed: _____ date 2/14/06 Installed by: R & H Inc. 704-746-4844

Improvement Permit by: Judy Mesnilly date 2-10-06 Operation Permit by: _____ date 6/26/06

Authorization to Construct by: Judy Mesnilly date 2-10-06 Existing System Inspection by: _____ date _____

HEALTH DEPT. COPY: WHITE OWNER COPY (FINAL): YELLOW OWNER COPY (INITIAL): PINK