IREDELL COUNTY HEALTH DEPARTMENT

STATESVILLE 704-878-5305 MOORESVILLE 704-664-5281

IMPROVEMENT PERMIT / AUTHORIZATION TO CONSTRUCT / OPERATION PERMIT / EXISTING SYSTEM INSPECTION

PERMIT# 079952 PIN# 4646302857 DATE 6-17-99

OWNER OR CONTRACTOR William Davis PHONE: Business _____ Home 704-663-2054

ADDRESS 118 Beach LN, Mooresville NC 28117

LOCATION Williamson, TR Alcove, TR Catalina on ~~EL~~ (L) just past Cottage Place 351 Catalina Dr.

SUBDIVISION Catalina Cove BLOCK / SECTION — LOT 8 LOT AREA .46 SITE CLASS. PS DESIGN FLOW 360 L.T.A.R. _____

Septic Tank: 1200 Gallons; STB 794 Date 8/1/99
Pump Tank: 1000 Gallons; PT 27 Date 9/12/99
Pump Make: GOULDS Model WE03J1M Serial No. 4/20/99
Nitrification Field: No Fields 1 Square Feet 600 Linear Feet 200
No Lines 4@50 Trench Width 36" Max Trench Bottom Depth 36"

☒ New System ☐ Repair System Type: I, II, (III), IV, V, VI
System Description: Pump/PM/Panel
Repair System Description: Same
Maintenance Agreement Required: ☐ Yes ☐ No
Gravel Depth N/A ☐ Slab ☒ Crawl Space ☐ Basement w/plumbing ☐ Basement wo/plumbing


☒ House/Mod. Home No. Bedrooms 3
☐ Mobile Home No. Bathrooms 2
☐ Business No. Employees ____
☐ Other _____

Water Supply: ☑ Individual ☐ Public ☐ Community


Comments:/Conditions:

Comments:/Conditions:

INITIAL SITE SKETCH

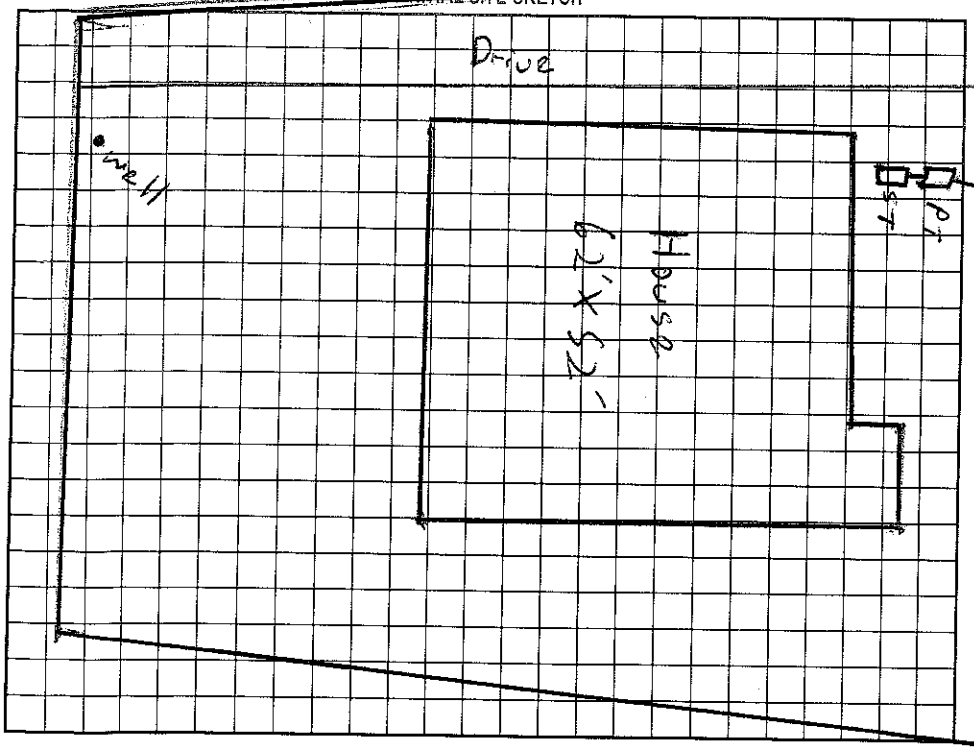

AS BUILT SKETCH

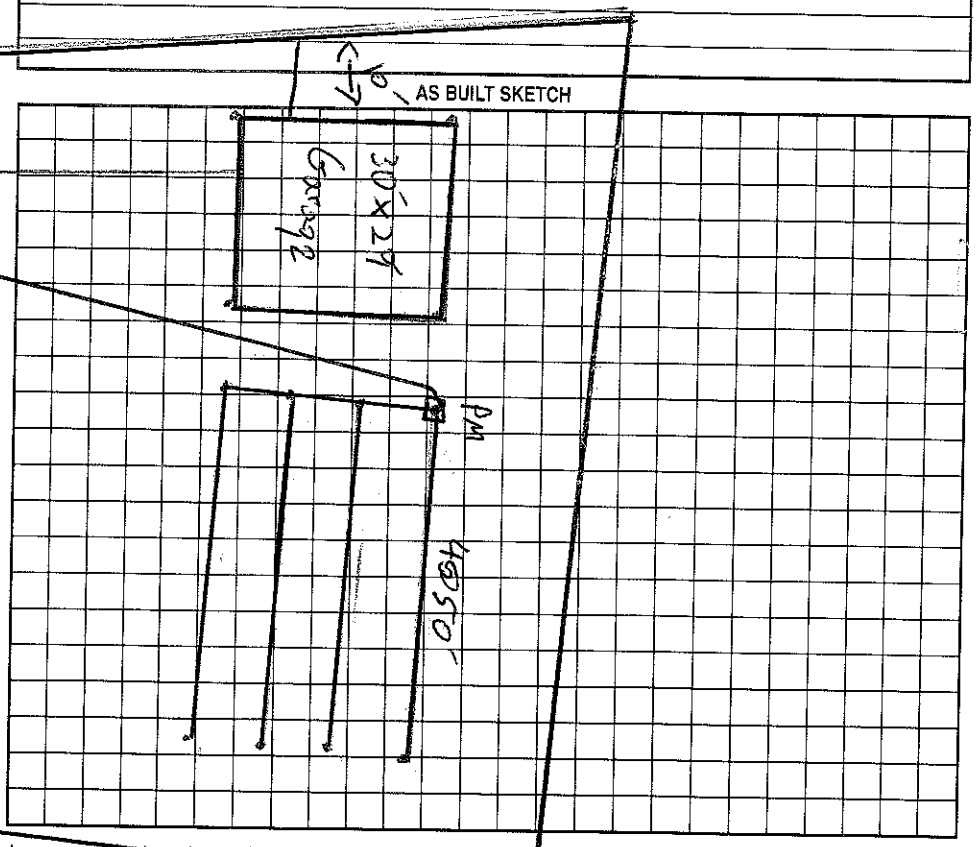

Permit can be suspended or revoked if any false information is supplied toward securing the permit/any unauthorized changes are made to the site/any unauthorized changes are made in the installation of the system. Improvement Permit with plat valid without expiration. Improvement Permit with site plan valid for sixty months. Authorization to Construct is valid for a period equal to that of Improvement Permit – not to exceed sixty months.

Signed: W. J. D. date 6-18-99

Improvement Permit by: Jeff Morgan date 6-17-99

Authorization to Construct by: Jeff Morgan date 6-17-99

Installed by: Bob McCarver

Operation Permit by: Wesley Sparks RS. date 5/3/00

Existing System Inspection by: _____ date _____

HEALTH DEPT. COPY: WHITE OWNER COPY (FINAL): YELLOW OWNER COPY (INITIAL): PINK