IREDELL COUNTY HEALTH DEPARTMENT STATESVILLE 704-878-5305 ~~MOORESVILLE 704-664-5281~~

IMPROVEMENT PERMIT / AUTHORIZATION TO CONSTRUCT / OPERATION PERMIT / EXISTING SYSTEM INSPECTION

PERMIT # 165907 PIN # 4646305686 DATE 4-14-2011

OWNER or APPLICANT Peconic Bay Homes/June Rogers PHONE: Business 704663-6693 Home: 704663-6693

OWNER or APPLICANT ADDRESS 141 Cedarwoods Mooresville NC 28117

LOCATION / DIRECTIONS Williamson TR at Alcove Rd TR Catalina Dr nearend on left #365

SUBDIVISION Catalina Cove BLOCK / SECTION LOT # 12 LOT AREA DESIGN FLOW 240 L.T.A.R.

Septic Tank 1250 Gallons: STB Date

Pump Tank Gallons: P T Date

Pump Make Model Serial #

Nitrification Field No Fields 1 No Lines 4 Linear Feet 240Ft

Trench Width 36" Max. Trench Bottom Depth 36" Gravel Depth 12" ☒ GRAVITY ☐ PRESSURE

☐ New System ☐ Repair ☐ Expansion System Type I (II) III IV V VI

System Description: EXIST Gravity - Conventional

Repair System Description: Modified

Maintenance Agreement Required ☐ YES ☒ NO

☒ Residence No. Bedrooms

☐ Business No. Persons

☐ Other No. Employees

☐ Slab ☐ Crawl Space


☐ Basement w/plumbing ☐ Basement w/o plumbing

Water Supply: ☒ Private ☐ Public ☐ Community

Comments / Conditions: ~~X~~ Note: Well must be abandoned prior to Termite poisoning.

Comments / Conditions: Existing Septic System appears to be functioning okay at time of inspection. Proposed addition will be at least 5ft from Septic System & Should not impact it.

INITIAL SITE SKETCH

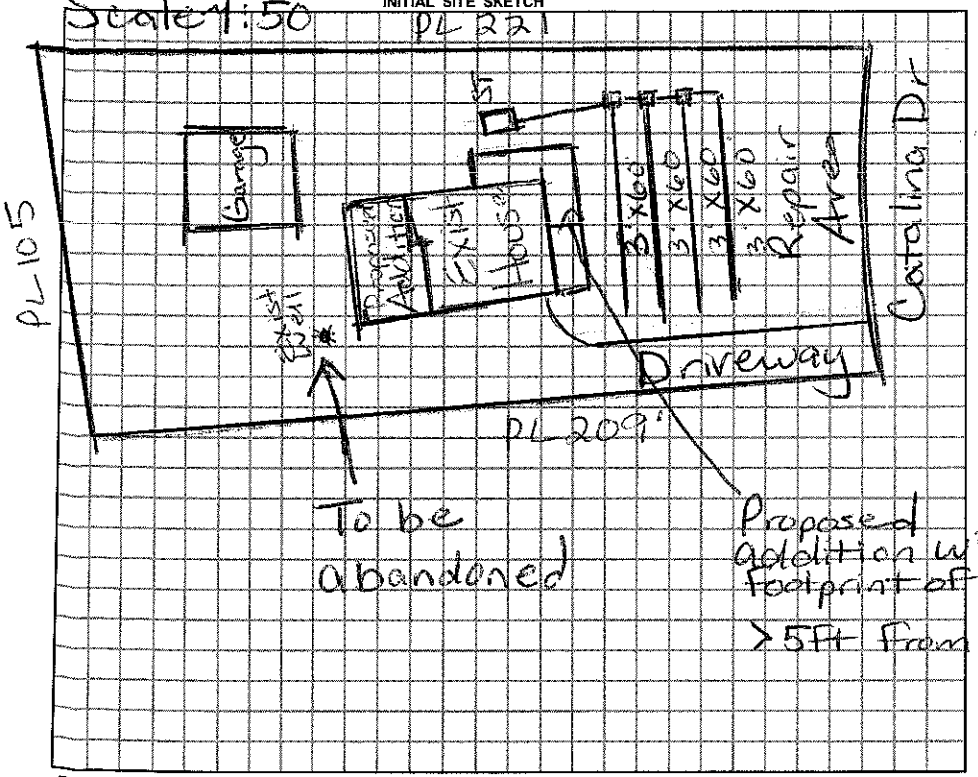

AS BUILT SKETCH

Permit can be suspended or revoked if any false information is supplied toward securing the permit / any unauthorized changes are made to the site / any unauthorized changes are made in the installation of the system.

☐ *IMPROVEMENT PERMIT w / plat valid without expiration* ☐ *IMPROVEMENT PERMIT w / site plan valid for 60 mos.* ☐ *AUTHORIZATION TO CONSTRUCT valid for period equal to IMPROVEMENT PERMIT-not to exceed 60 mo.*

Owner / Applicant Signature: X Date 4/21/11

Improvement Permit by: Date

Authorization to Construct by: Date

Installed by:

Operation Permit by: Date:

Existing System Inspected by: Maria H Dotson REHS Date: 4/14/2011

YOU SHOULD CONTACT A LOCATOR SERVICE PRIOR TO ANY EXCAVATION.

WHITE COPY Environmental Health YELLOW COPY (Final) Owner / Applicant PINK COPY (Initial) Owner / Applicant