11:30

IREDELL COUNTY HEALTH DEPARTMENT

.ATESVILLE 704-878-5305 MOORESVILLE 704-664-5281

IMPROVEMENT PERMIT / CERTIFICATE OF COMPLETION / OPERATION PERMIT / EXISTING SYSTEM INSPECTION

PROPERTY DESCRIPTION NO. 21817 DATE 8/31/95 TAX MAP NO. 2G-5-B-31 Watershed: X Yes ☐ No

OWNER OR CONTRACTOR Elizabeth Lambert PHONE: Business PIN # 4646-30-9145 Home

ADDRESS 10003 Queens Oak Ct. Charlotte NC. 28210

LOCATION Catalina Rd. ~ 1.5 miles on R before road

SUBDIVISION Catalina Cove BLOCK / SECTION LOT 31 LOT AREA ~.66 Ac SITE CLASS. PS DESIGN FLOW 360 L.T.A.R. .3

Septic Tank: 1000 Gallons; STB 786 Date 7/3/97

Pump Tank: Gallons; PT Date

Pump Make: Model Serial No.

Nitrification Field: No Fields 1 Square Feet 1200 Linear Feet * 210

No Lines 3 Trench Width 24 Max Trench Bottom Depth 28" Gravel Depth 6" STONE

X New System ☐ Repair System Type: I, II, III, IV, V, VI

System Description: GRAV / PANEL 16"

Repair System Description: SAME

Maintenance Agreement Required: ☐ Yes ☐ No

X House/Mod. Home No. Bedrooms 3

☐ Mobile Home No. Bathrooms 2.5

☐ Business No. Employees

☐ Other


☐ Slab X Crawl Space ☐ Basement w/plumbing ☐ Basement wo/plumbing

Water Supply: X Individual ☐ Community ☐ Public

Comments: * 50% reduction for PPBS use

Comments:

INITIAL SITE SKETCH

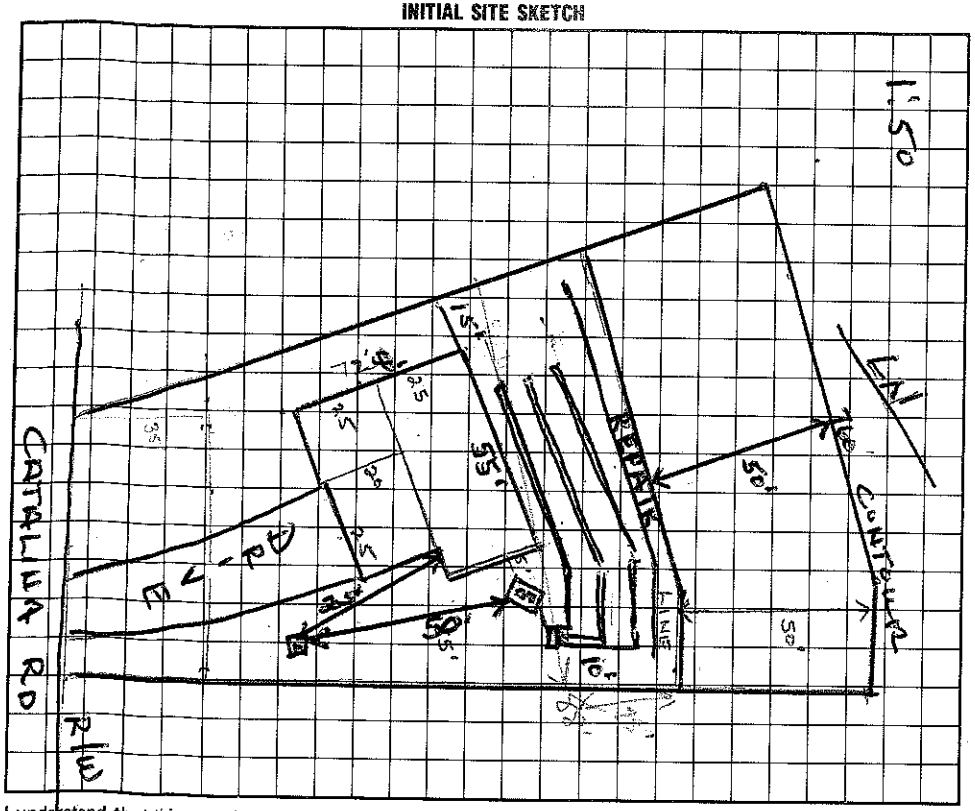

AS BUILT SKETCH

Installed as sketch

I understand that this permit can be suspended or revoked if any false information is supplied toward securing the permit/any unauthorized changes are made to the site/any unauthorized changes are made in the installation of the system.

Signed: J. Kryan, Agent

Improvement Permit by: Wesley Sparks RS. date 8/31/95

Existing System Inspection by: date

Installed by: Kennedy Grading

Certificate of Completion by: Maria Dotson date 9/9/97

Operation Permit by: Maria Dotson date 9/9/97

HEALTH DEPT. COPY: WHITE INSPECTION COPY (FINAL): GREEN OWNER COPY (FINAL): YELLOW INSPECTION COPY (INITIAL): PINK OWNER COPY (INITIAL): GOLD