4[00]

IREDELL COUNTY HEALTH DEPARTMENT

STATESVILLE 704-878-5300 MOORESVILLE 704-664-5281

IMPROVEMENT PERMIT / AUTHORIZATION TO CONSTRUCT / OPERATION PERMIT / EXISTING SYSTEM INSPECTION

PERMIT# 071564 PIN# 4646322835 DATE 3/12/98

OWNER OR CONTRACTOR Rick Swann / Lake Construction PHONE: Business 663-4273 Home 867-3894

ADDRESS 125 Sweetbriar Ln Mooresville, NC 28115

LOCATION Williamson Rd TL Ponderosa TL at Fork on Lt. before Pavement

SUBDIVISION Bonanza BLOCK / SECTION ~~40~~ LOT 40 LOT AREA ~39,000 ft2 SITE CLASS. PS DESIGN FLOW 360 L.T.A.R. .3

Septic Tank: 1000 Gallons; STB 825 Date 10-11-98

Pump Tank: 1000 Gallons; PT 47-1087 Date 8-11-98

Pump Make: Zoeller Model N163E Serial No. 163-000211

Nitrification Field: No Fields 1 Square Feet * 900 Linear Feet * 300

No Lines 6 @ 50' Trench Width 36" Max Trench Bottom Depth 36" Gravel Depth N/A

☒ New System ☐ Repair System Type: I, II, (III), IV, V, VI

System Description: Pump (PM) to Plastic Chambers

Repair System Description: Same or Similar

Maintenance Agreement Required: ☐ Yes ☒ No

☐ Slab ☐ Crawl Space ☒ Basement w/plumbing ☐ Basement wo/plumbing

☐ House/Mod. Home ☒ Mobile Home ☐ Business ☐ Other


No. Bedrooms 3 No. Bathrooms 2.5 No. Employees ____

Water Supply: ☒ Individual ☐ Public ☐ Community

Comments:/Conditions: * 25% reduction in Drainfield. Keep Septic System at least 10' From Property lines & 50' from any wells & 50' From 760 Contour of lake.

Comments:/Conditions: Need Well Variance from DEHNR. *Well variance attached 54 ft btw Tanks & well. Tanks & lines checked 12/2/98, Pressure tested 12/3/98 MD & JM

INITIAL SITE SKETCH Scale 1:50

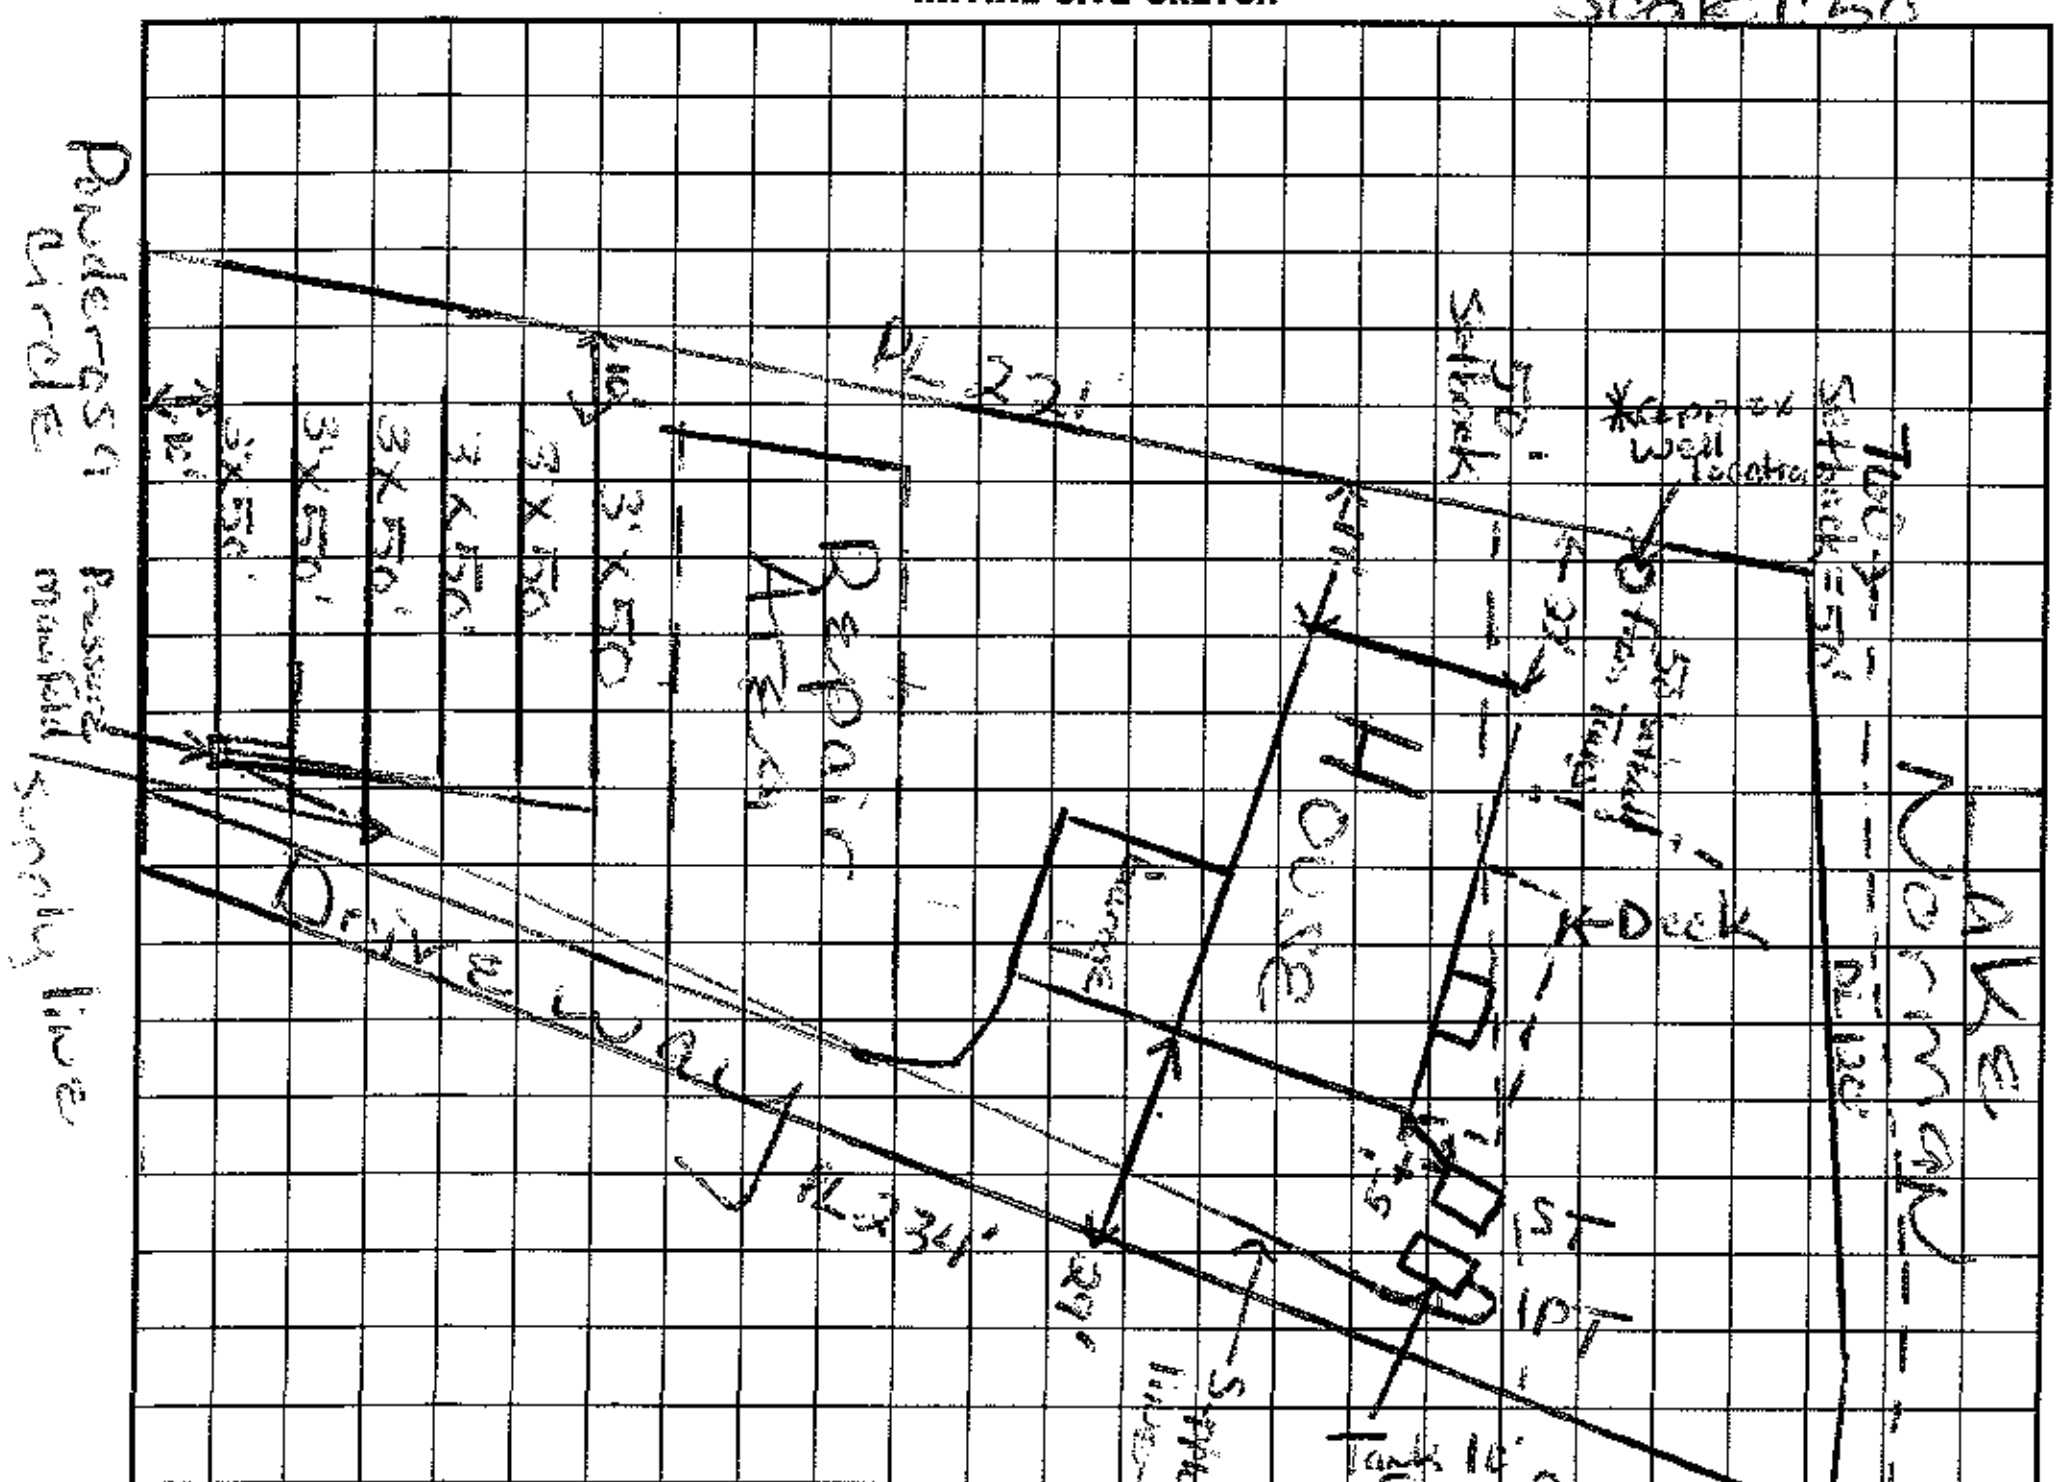

AS BUILT SKETCH

I understand that this permit can be suspended or revoked if any false information is supplied toward securing the permit/any unauthorized changes are made to the site/any unauthorized changes are made in the installation of the system. Improvement Permit with plat valid without expiration. Improvement Permit with site plan valid for sixty months. Authorization to Construct is valid for a period equal to that of Improvement Permit – not to exceed sixty months.

Signed: Charles Huxley date 3-12-98

Improvement Permit by: Maria H. Dotson date 3-16-98

Authorization to Construct by: Maria H. Dotson date 3/23/98

Installed by: Benny Myers

Operation Permit by: Jeff Morgan / Maria Dotson date 12/29/98

Existing System Inspection by: Maria Dotson date 12/29/98

HEALTH DEPT. COPY: WHITE INSPECTION COPY (FINAL): GREEN OWNER COPY (FINAL): YELLOW INSPECTION COPY (INITIAL): PINK OWNER COPY (INITIAL): GOLD