IREDELL COUNTY HEALTH DEPARTMENT

Statesville Office (704) 878-5305 Mooresville Office (704) 660-3625 PERMIT # 180844

IMPROVEMENT PERMIT / AUTHORIZATION TO CONSTRUCT / OPERATION PERMIT / EXISTING SYSTEM

PIN # 4646 324 314

APPLICANT: SCOTT OLDENBURG APPLICANT ADDRESS: PO BOX 365 TERRELL, NC 28682

SITE ADDRESS: MALIBU RD PHONE: ALT. PHONE: 704 201 1095

SITE DIRECTIONS: ALCOVE FROM WILLIAMSON - TR CATALINA - SEPTIC ON LT CORNER OF MALIBU - LOT ON RT

SUBDIVISION: BACK FORTY SECTION: LOT # 4A LOT AREA: DESIGN FLOW: 360 L.T.A.R.: .3

Septic Tank 1000 (gal) STB 1012 Date 5-16-14
Pump Tank 1000 (gal) PT 17 Date 3-11-14
Pump Make Goulds Model WE1012HC Serial # E14491
Nitrification Fields 1 # Lines 3 Linear Ft: 210
Trench Width 24" Max. Trench Bottom Depth 36" Gravel Depth N/A

☑ New System ☐ Repair ☐ Expansion System Type: I II III (IV) V VI
System Description: LP PBBPS OFFSITE
Repair System Description: LP PBBPS OFFSITE
Maintenance Agreement Required: ☑ YES ☐ NO
☐ GRAVITY ☑ PRESSURE


☑ Residence No. Bedrooms 3
☐ Business No. Persons 6
☐ Other No. Employees
☐ Slab ☑ Crawl Space
☐ Basement w/plumbing ☐ Basement w/o plumbing

Water Supply: ☑ Private ☐ Public ☐ Community

Comments / Conditions: DO NOT ISSUE A/C UNTIL R/W CROSSING PERMISSION(S) HAVE BEEN ESTABLISHED. SITE IS LANDLOCKED.


3 11/16 hole drill eats
16 panels per detail
5/14/14 Checked drainfield
7/18/14 Checked tanks, meets setbacks

INITIAL SITE SKETCH

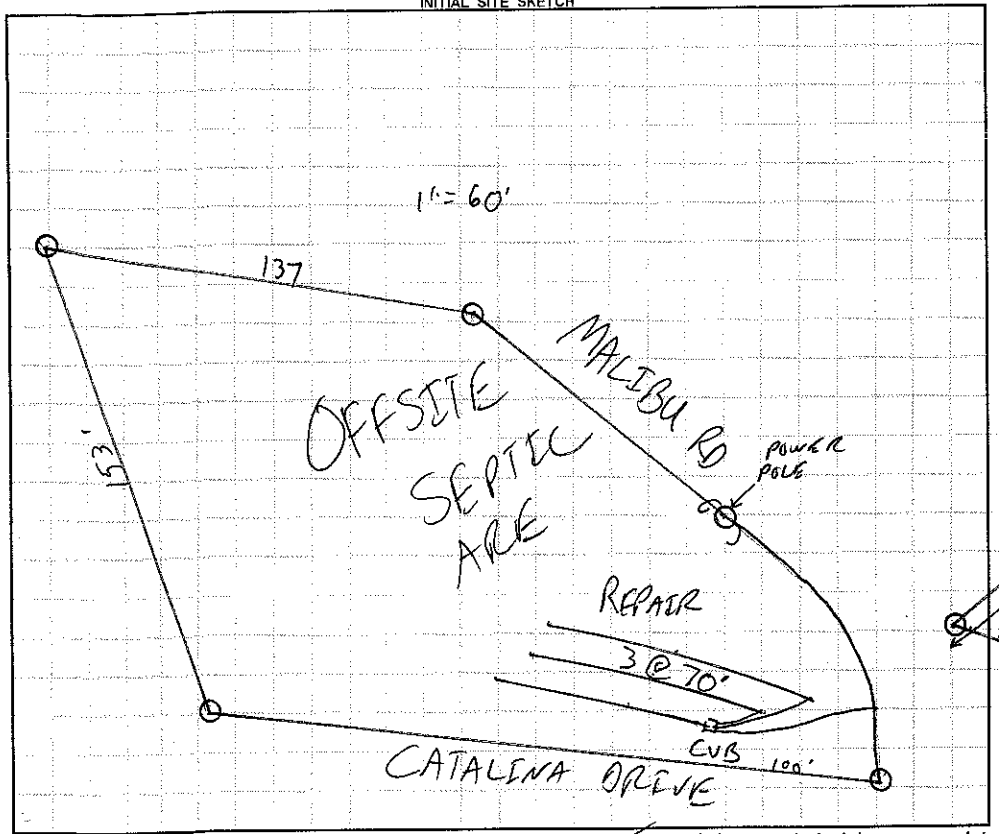

AS BUILT SKETCH

8/22/94 Set 2ft pressure
Checked elect & alarm
Maintenance Contract Received
9-3-14 RR

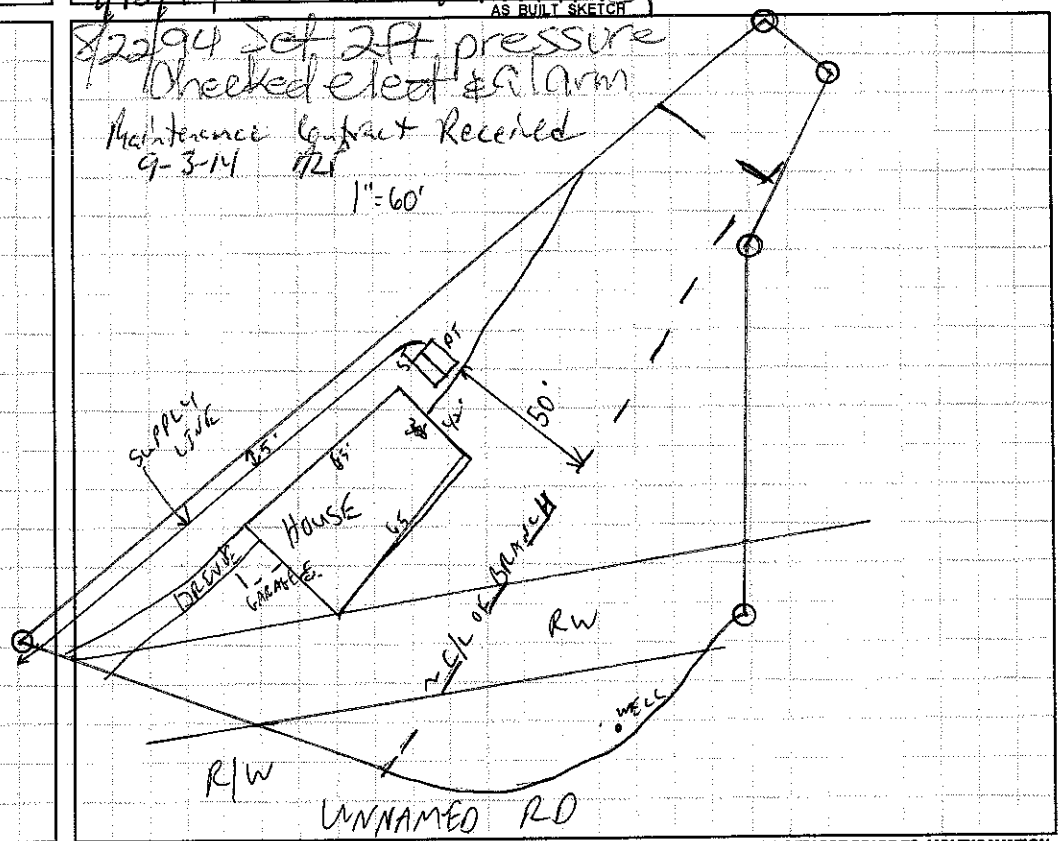

Permit can be suspended or revoked if any false information is supplied toward securing the permit / any unauthorized changes are made to the site / any unauthorized changes are made in the installation of the system. **CONTACT A LOCATOR SERVICE PRIOR TO ANY EXCAVATION**

☐ **IMPROVEMENT PERMIT** *with plat* valid without expiration. ☑ **IMPROVEMENT PERMIT** *with site plan* valid for 60 mos. ☐ **AUTHORIZATION TO CONSTRUCT** valid for period equal to IMPROVEMENT PERMIT--not to exceed 60 mo.

Owner / Applicant Signature: Date: 10-24-2013 Installed by: Steve Jordon (Piedmont Backhoe)

MENT PERMIT by: Date: 10/25/13 OPERATION PERMIT by: Date: 9-3-14

TION TO CONSTRUCT by: Date: 3/07/14 Existing System Inspected by: Date:

Health Dept. Copy - WHITE Applicant (Final Approval) - YELLOW Applicant (Conditional Approval) - PINK