IREDELL COUNTY HEALTH DEPARTMENT

STATESVILLE 704-878-5305 MOORESVILLE 704-664-5281

IMPROVEMENT PERMIT / AUTHORIZATION TO CONSTRUCT / OPERATION PERMIT / EXISTING SYSTEM INSPECTION

PERMIT# 129143 PIN# 4664633019 1 DATE 7-14-05

OWNER OR CONTRACTOR Gerritt Howard PHONE: Business (704) 507-2141 Home (704) 483-3023

ADDRESS 4986 Baywater Ln Denver NC 28037

LOCATION Williamson Rd TL Ponderosa Circle bear left at fork property on right

SUBDIVISION Bonanza BLOCK / SECTION ____ LOT 83 LOT AREA .5 Acre SITE CLASS. PS DESIGN FLOW 360 gpd L.T.A.R. .3

Septic Tank: 1000 Gallons; STB 794 Date 11-16-05

Pump Tank: ____ Gallons; PT ____ Date ____

Pump Make: ____ Model ____ Serial No. ____

Nitrification Field: No Fields 1 Square Feet 900' Linear Feet 300'

No Lines 4@75' Trench Width 36" Max Trench Bottom Depth 36" Gravel Depth N/A

X New System ☐ Repair System Type: I, II, III, IV, V, VI

System Description: Gravity - 25% Reduction

Repair System Description: Panel Block

Maintenance Agreement Required: ☐ Yes ☐ No

X House/Mod. Home ☐ Mobile Home ☐ Business ☐ Other

No. Bedrooms 3 No. Bathrooms 2.5 No. Employees ____


☐ Slab X Crawl Space ☐ Basement w/plumbing ☐ Basement wo/plumbing

Water Supply: X Individual ☐ Public ☐ Community


Comments:/Conditions: Keep Septic System at least 10' From PL, 50-100' from well a at least 10' to House.

Comments:/Conditions:

INITIAL SITE SKETCH Scale 1:40'

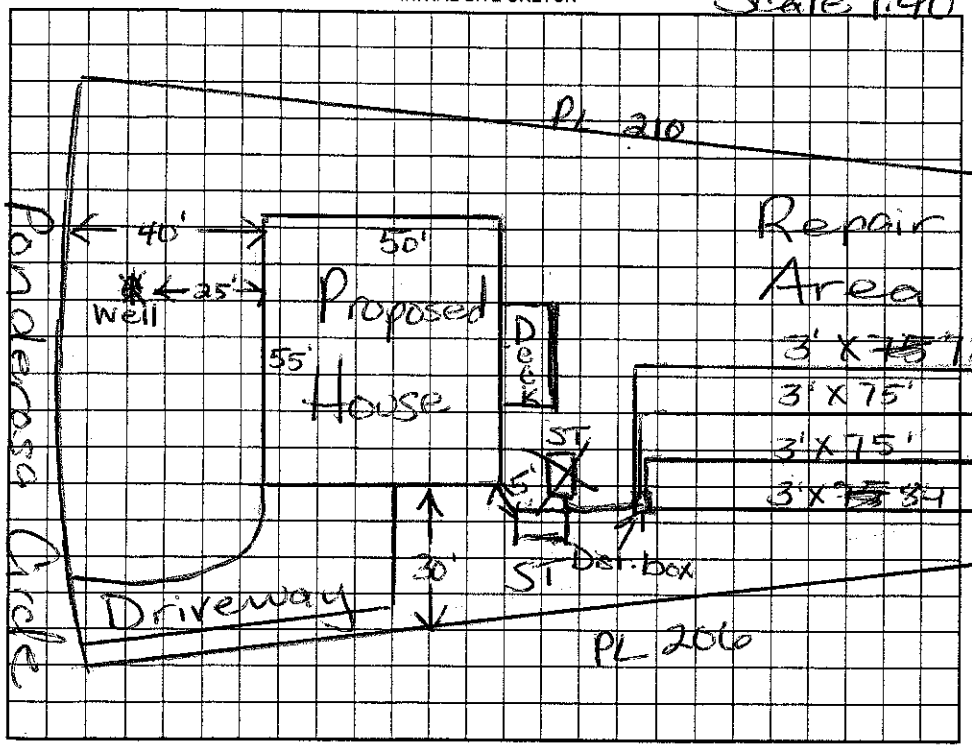

AS BUILT SKETCH

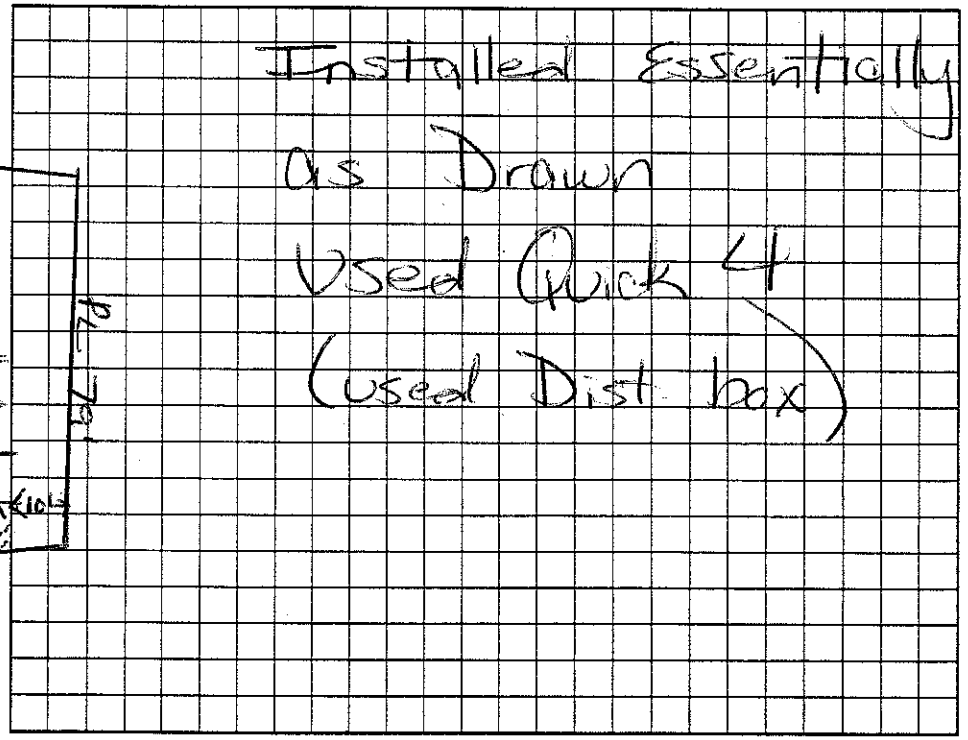

Permit can be suspended or revoked if any false information is supplied toward securing the permit/any unauthorized changes are made to the site/any unauthorized changes are made in the installation of the system. Improvement Permit with plat valid without expiration. Improvement Permit with site plan valid for sixty months. Authorization to Construct is valid for a period equal to that of Improvement Permit – not to exceed sixty months.

Signed: Gerritt Howard date 7/14/05 Installed by: Howard's Backhoe

Improvement Permit by: Maint. Tech Dotson RS date 7/14/05 Operation Permit by: Maint. Tech Dotson RS date 12/20/05

Authorization to Construct by: Maint. Tech Dotson RS date 7/14/05 Existing System Inspection by: ____ date ____

HEALTH DEPT. COPY: WHITE OWNER COPY (FINAL): YELLOW OWNER COPY (INITIAL): PINK