10:00

IREDELL COUNTY HEALTH DEPARTMENT

STATESVILLE 704-878-5305 MOORESVILLE 704-664-5281

IMPROVEMENT PERMIT / AUTHORIZATION TO CONSTRUCT / OPERATION PERMIT / EXISTING SYSTEM INSPECTION

PERMIT# 129145 PIN# 4646332100 DATE 7-14-05

OWNER OR CONTRACTOR Gerritt or Blake Howard PHONE: Business 704 507-2141 Home (704) 483-3023

ADDRESS 4986 Baywater Ln Denver NC 28037

LOCATION US 21 South Cross over I-77 turns into Williamson TL Ponderosa Circle bear right at fork lot on right

SUBDIVISION Bonanza BLOCK / SECTION ____ LOT 84 LOT AREA .486 SITE CLASS. PS DESIGN FLOW 360gpd L.T.A.R. .3

Septic Tank: 1000 Gallons; STB 714 Date 11-16-05 [X] New System [ ] Repair System Type: [I] II III IV V VI [X] House/Mod. Home No. Bedrooms 3 Water Supply: [X] Individual

Pump Tank: ____ Gallons; PT ____ Date ____ System Description: Gravity-25% Reduction [ ] Mobile Home No. Bathrooms 2.5 [ ] Public [ ] Community

Pump Make: ____ Model ____ Serial No. ____ Repair System Description: Same [ ] Business No. Employees ____


Nitrification Field: No Fields 1 Square Feet 900' Linear Feet 300' Maintenance Agreement Required: [ ] Yes [X] No [ ] Other ____

No Lines 4@75' Trench Width 36" Max Trench Bottom Depth 36" Gravel Depth N/A [ ] Slab [X] Crawl Space [ ] Basement w/plumbing [ ] Basement wo/plumbing


Comments:/Conditions: Keep Septic System at least 10' from PL.

Comments:/Conditions: Any future pool must be at least 15' From Septic System (and Repair area).

INITIAL SITE SKETCH 1:40

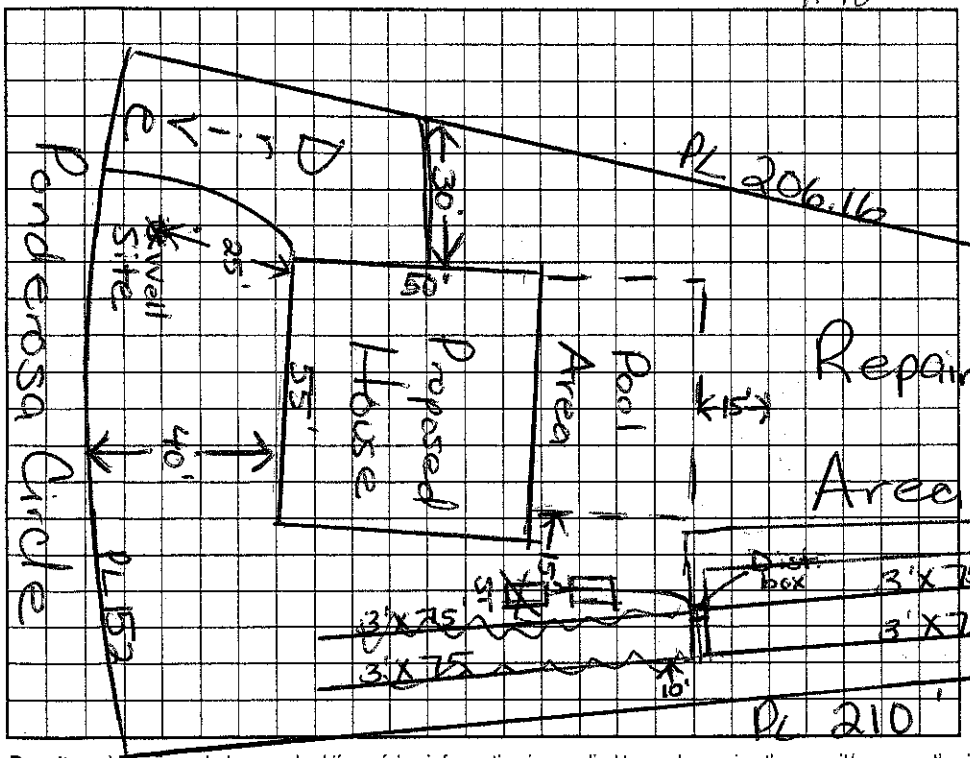

AS BUILT SKETCH

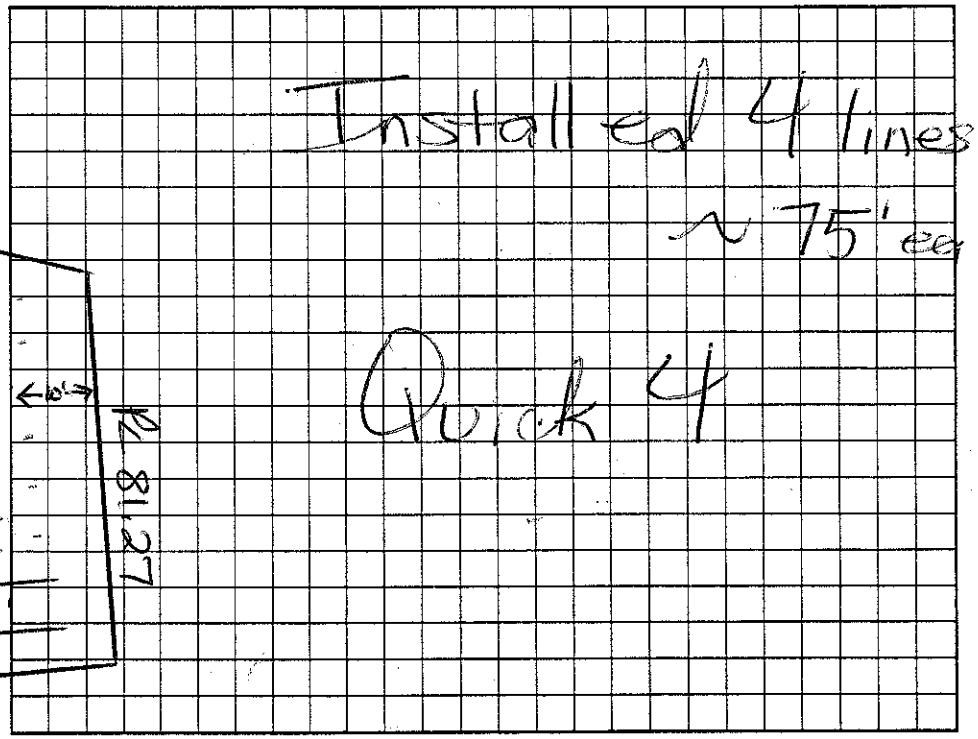

Permit can be suspended or revoked if any false information is supplied toward securing the permit/any unauthorized changes are made to the site/any unauthorized changes are made in the installation of the system. Improvement Permit with plat valid without expiration. Improvement Permit with site plan valid for sixty months. Authorization to Construct is valid for a period equal to that of Improvement Permit – not to exceed sixty months.

Signed: Gerritt Howard date 7/14/05 Installed by: Howard's Backhoe

Improvement Permit by: Maria H Dotson RS date 7/14/05 Operation Permit by: Maria H Dotson RS date 12/21/05

Authorization to Construct by: Maria H Dotson RS date 7/14/05 Existing System Inspection by: ____ date ____

HEALTH DEPT. COPY: WHITE OWNER COPY (FINAL): YELLOW OWNER COPY (INITIAL): PINK