IREDELL COUNTY HEALTH DEPARTMENT - *ENVIRONMENTAL HEALTH* ☐ STATESVILLE OFFICE 704-878-5305 ☒ MOORESVILLE OFFICE 704-664-5281

IMPROVEMENT PERMIT / AUTHORIZATION TO CONSTRUCT / OPERATION PERMIT / EXISTING SYSTEM INSPECTION

PERMIT # 168339 PIN # 4646-33-3112 DATE 9-9-11

OWNER Doug Catrona APPLICANT: Same PHONE: Home/Cell # 704-662-2742 Business #

SITE ADDRESS 393 Ponderosa Cr OWNER / APPLICANT ADDRESS Same

SITE DIRECTIONS 21, Cross 77, TL Ponderosa, on L

SUBDIVISION Bonanza BLOCK / SECTION LOT # 85 LOT AREA .53 DESIGN FLOW 360 L.T.A.R. .3

Septic Tank Ex 1000 Gallons: STB 312 Date 12-20-04 ☐ New System ☐ Repair ☐ Expansion System Type I II (III) IV V VI ☒ Residence No. Bedrooms 3 **Water Supply** ☒ Private

Pump Tank Gallons: PT Date ☐ Business No. Persons ☐ Public

Pump Make Model Serial # System Description: 25% (EZ Flow) ☒ Other No. Employees ☐ Community

No. Nitrification Fields: ~~No. Lines~~ X 151 Linear Feet Repair System Description: LP Panel Block ☐ Slab ☒ Crawl Space

Trench Width Max. Trench Bottom Depth NG Maintenance Agreement Required ☐ YES ☒ NO ☐ Basement w/plumbing ☐ Basement w/o plumbing


Gravel Depth ☒ GRAVITY ☐ PRESSURE

Comments / Conditions Shed Must Be 5' From Septic

Shed

INITIAL SITE SKETCH

AS BUILT SKETCH

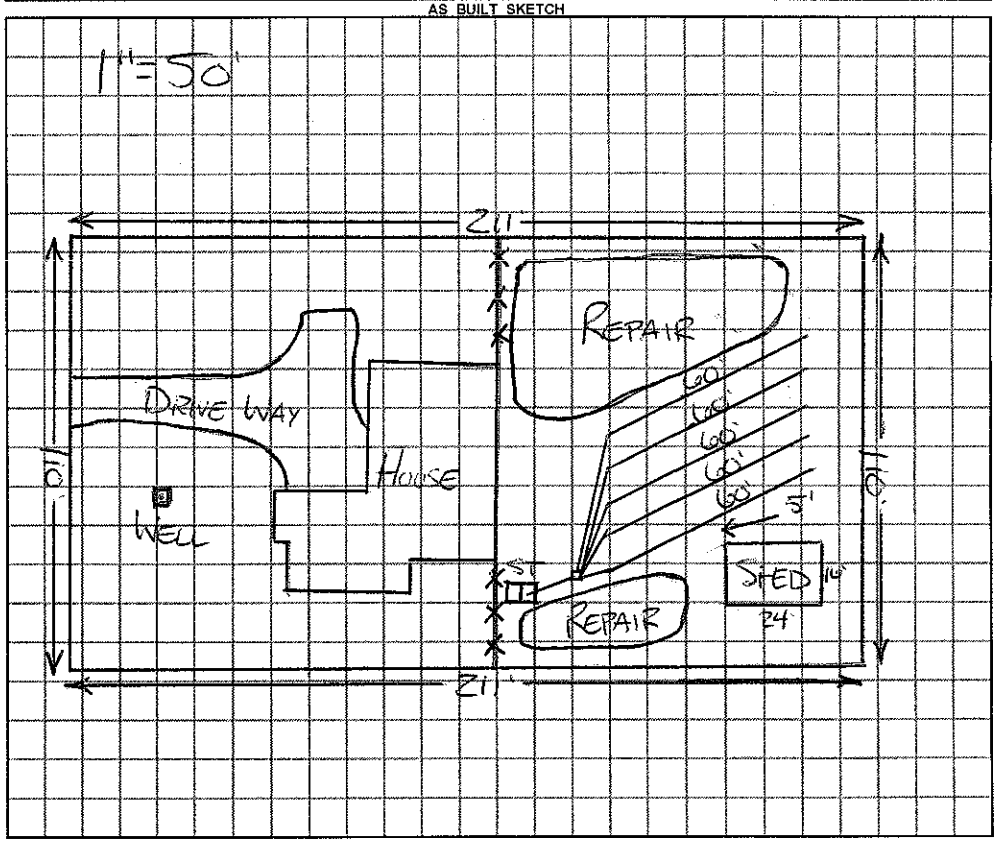

Permit can be suspended or revoked if any false information is supplied toward securing the permit / any unauthorized changes are made to the site / any unauthorized changes are made in the installation of the system.

☐ ***IMPROVEMENT PERMIT*** *with plat valid without expiration.* ☐ ***IMPROVEMENT PERMIT*** *with plat valid without expiration. site plan valid 60 mo.* ☐ ***AUTHORIZATION TO CONSTRUCT*** valid for period equal to IMPROVEMENT PERMIT--not to exceed 60 mo.

Owner / Applicant Signature: Doug Catrona Date 9/9/11 Installed by:

IMPROVEMENT PERMIT by: ***REHS*** Date OPERATION PERMIT by: ***REHS*** Date

AUTHORIZATION TO CONSTRUCT by: ***REHS*** Date Existing System Inspected by: ***REHS*** Date 9-9-11

YOU SHOULD CONTACT A LOCATOR SERVICE PRIOR TO ANY EXCAVATION

White Copy -- Environmental Health YELLOW COPY (Fi- PINK COPY (Initial) Owner / Applicant