IREDELL COUNTY HEALTH DEPARTMENT
IMPROVEMENT PERMIT / AUTHORIZATION TO CONSTRUCT / OPERATION PERMIT / EXISTING SYSTEM INSPECTION

STATESVILLE 704-878-5305 MOORESVILLE 704-664-5261

130.00 E-419 3:30

PERMIT# 124306 PIN# 4646-33-3112

OWNER OR CONTRACTOR Leeron Howard PHONE: Business 704 517-6200 Home

ADDRESS 8025 Webbs Rd Denver NC 28037 DATE 10-27-09

LOCATION W. Allenson, R Pinecrest Cir, L Ponderosa Cir, L Ponderosa Cir on Rt

SUBDIVISION Bonanza BLOCK / SECTION LOT 85 LOT AREA 23,100 SQ FT SITE CLASS PS DESIGN FLOW 360 L.T.A.R. 0.3

Septic Tank: 1000 Gallons; STB 312 Date 12/20/04

Pump Tank: Gallons; PT Date

Pump Make: Model Serial No.

Mnification Field: No Fields 1 Square Feet 900 Linear Feet 300

No Lines 5 @ 60' Trench Width 36" Max Trench Bottom Depth 36" Gravel Depth

☒ New System ☐ Repair System Type: I II III IV V VI

System Description: Gravity 25% Reduct

Repair System Description: Panel Block

Maintenance Agreement Required: ☐ Yes ☒ No

☒ House/Mod. Home No. Bedrooms 3

☐ Mobile Home No. Bathrooms

☐ Business No. Employees

☐ Other


☐ Slab ☒ Crawl Space ☐ Basement w/plumbing ☐ Basement w/o plumbing

Water Supply: ☒ Individual ☐ Public ☐ Community


Comments/Conditions:

Comments/Conditions:

INITIAL SITE SKETCH

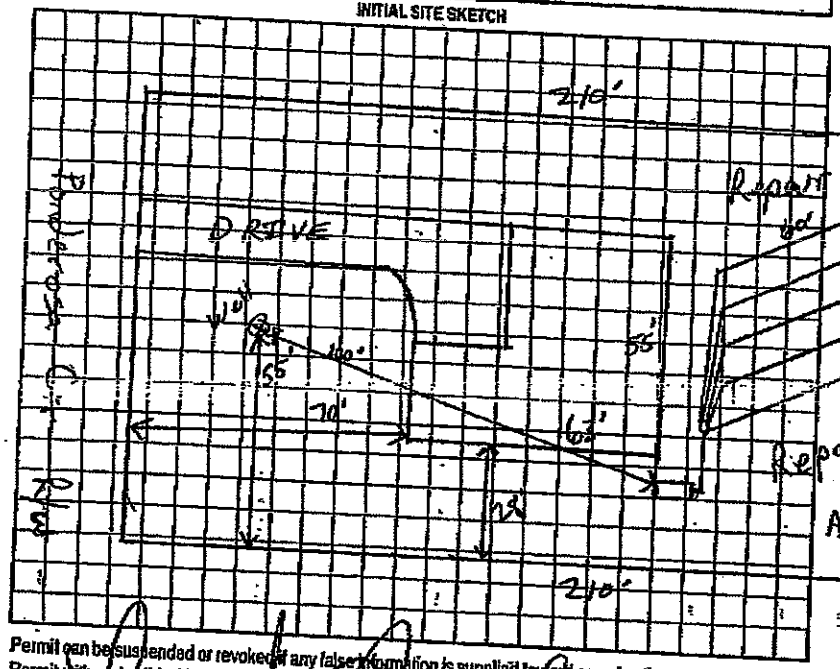

AS BUILT SKETCH

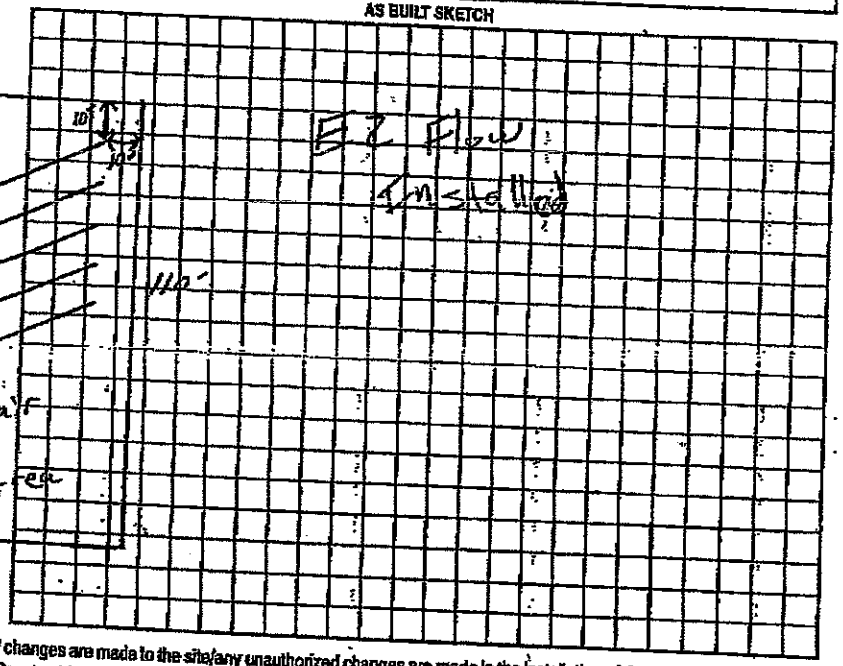

Permit can be suspended or revoked if any false information is supplied toward securing the permit/any unauthorized changes are made to the site/any unauthorized changes are made in the installation of the system. Improvement Permit with plat valid without expiration. Improvement Permit with site plan valid for sixty months. Authorization to Construct is valid for a period equal to that of Improvement Permit – not to exceed sixty months.

Signed: Leeron M. Howard date 10/27/09 Installed by: Howard's Backhoe

Improvement Permit by: LS date 10/27/09 Operation Permit by: LS date 2/11/05

Authorization to Construct by: LS date 10/27/09 Existing System Inspection by: date

HEALTH DEPT. COPY: WHITE OWNER COPY (FINAL): YELLOW OWNER COPY (INITIAL): PINK

05/12/2011 16:49 7046623239 PAGE 02