IREDELL COUNTY HEALTH DEPARTMENT

Statesville Office (704) 878-5305 Mooresville Office (704) 660-3625 PERMIT # 181273

IMPROVEMENT PERMIT / AUTHORIZATION TO CONSTRUCT / OPERATION PERMIT / EXISTING SYSTEM

PIN # 4646-33-4133

APPLICANT: CALEB HILL APPLICANT ADDRESS: 15506 CARRINGTON RIDGE DR.

SITE ADDRESS: PONDEROSA CIR. PHONE: 704-302-6076 ALT. PHONE:


SITE DIRECTIONS: 21 S, WILLIAMSON, TL PONDEROSA,

SUBDIVISION: BONANZA SECTION: LOT # 86 LOT AREA: .53 AC DESIGN FLOW: 480 L.T.A.R.: .3


Septic Tank	1000	(gal)	STB 825	Date	12-28-13	☒ New System ☐ Repair ☐ Expansion	System Type: I II III IV V VI	☒ Residence	No. Bedrooms	4	Water Supply
Pump Tank		(gal)	PT	Date		System Description:	25% REDUCTION	☐ Business	No. Persons		☒ Private
Pump Make		Model		Serial #		Repair System Description:	LP PANEL	☐ Other	No. Employees		☐ Public
# Nitrification Fields	1	# Lines	4	Linear Ft:	400'	Maintenance Agreement Required:	☐ YES ☒ NO	☒ Slab	☐ Crawl Space		☐ Community
Trench Width	36"	Max. Trench Bottom Depth	36"	Gravel Depth	—		☒ GRAVITY ☐ PRESSURE	☐ Basement w/plumbing		☐ Basement w/o plumbing	

Comments / Conditions:

INITIAL SITE SKETCH

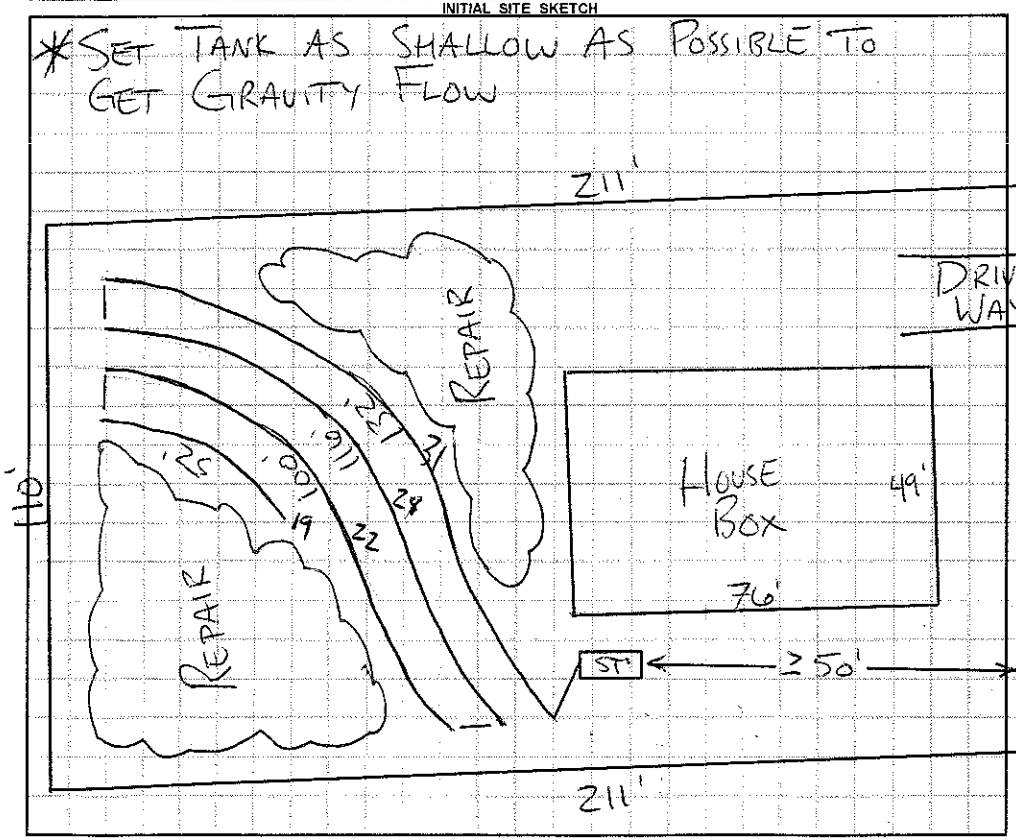

AS BUILT SKETCH

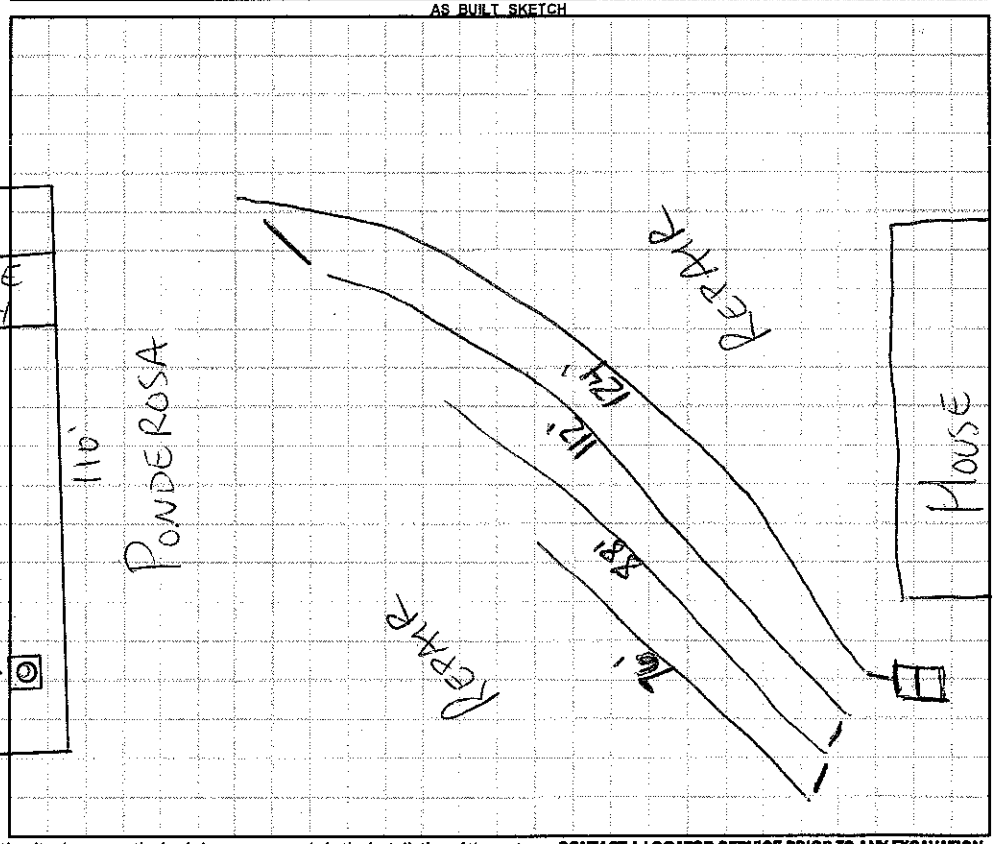

Permit can be suspended or revoked if any false information is supplied toward securing the permit / any unauthorized changes are made to the site / any unauthorized changes are made in the installation of the system. **CONTACT A LOCATOR SERVICE PRIOR TO ANY EXCAVATION**

☐ **IMPROVEMENT PERMIT** *with plat valid without expiration.* ☐ **IMPROVEMENT PERMIT** *with site plan valid for 60 mos.* ☒ **AUTHORIZATION TO CONSTRUCT** *valid for period equal to IMPROVEMENT PERMIT--not to exceed 60 mo.*

Owner / Applicant Signature: Date: 11-8-13 Installed by: ROWAN SEPTIC

IMPROVEMENT PERMIT by: Date: 11-5-13 OPERATION PERMIT by: Date: 2-11-14

AUTHORIZATION TO CONSTRUCT by: Date: 11-5-13 Existing System Inspected by: Date:

Health Dept. Copy - WHITE Applicant (Final Approval) - YELLOW Applicant (Conditional Approval) - PINK