OUNTY HEALTH DEPARTMENT

STATESVILLE 704-878-5305 MOORESVILLE 704-664-5281

ENT PERMIT / AUTHORIZATION TO CONSTRUCT / OPERATION PERMIT / EXISTING SYSTEM INSPECTION

621 PIN # 4646-35-4679 DATE 4-19-10

WILLIAM & PAMELA RIEMER PHONE: Business 704-662-8625 Home: PAUL SEME

ESS 419 SCOTIA LN LAURINBURG NC 28352

WILLIAMSON, TR SUNSET, TL ELYSIAN, ON R

OORELAND ESTATES BLOCK / SECTION LOT # 13 LOT AREA .51 DESIGN FLOW 240 GPD L.T.A.R. .3

1000 Gallons: STB 194 Date 5-28-11

1000 Gallons: P T 283 Date 5-30-11

Pump Make [redacted] Model Static Serial # 3HP 45

Nitrification Field No Fields 1 No Lines 5 Linear Feet 143'

Trench Width 24-36" Max. Trench Bottom Depth * 32" Gravel Depth SAND

☒ New System ☐ Repair ☐ Expansion System Type I II III (IV) V VI

System Description: LP- PANEL BLOCK

Repair System Description: LPP

Maintenance Agreement Required ☒ YES ☐ NO

☐ GRAVITY ☒ PRESSURE PARTIAL

☒ Residence No. Bedrooms 2

☐ Business No. Persons

☐ Other No. Employees

☐ Slab ☐ Crawl Space

☒ Basement w/plumbing ☐ Basement w/o plumbing

Water Supply: ☐ Private ☐ Public ☐ Community

Comments / Conditions 1) 12/2011 Checked tanks

9/27/2011 Checked PROPOSED lines

NEW WELL


Comments / Conditions 1) PROPERTY LINE SETBACK MIN 5'

2) 32" TRENCH BOTTOM MAX TO STAY 12" ABOVE SAP


3) SHOWN WELL MUST BE ABANDOND BEFORE AC

3/16" hole drilled

INITIAL SITE SKETCH

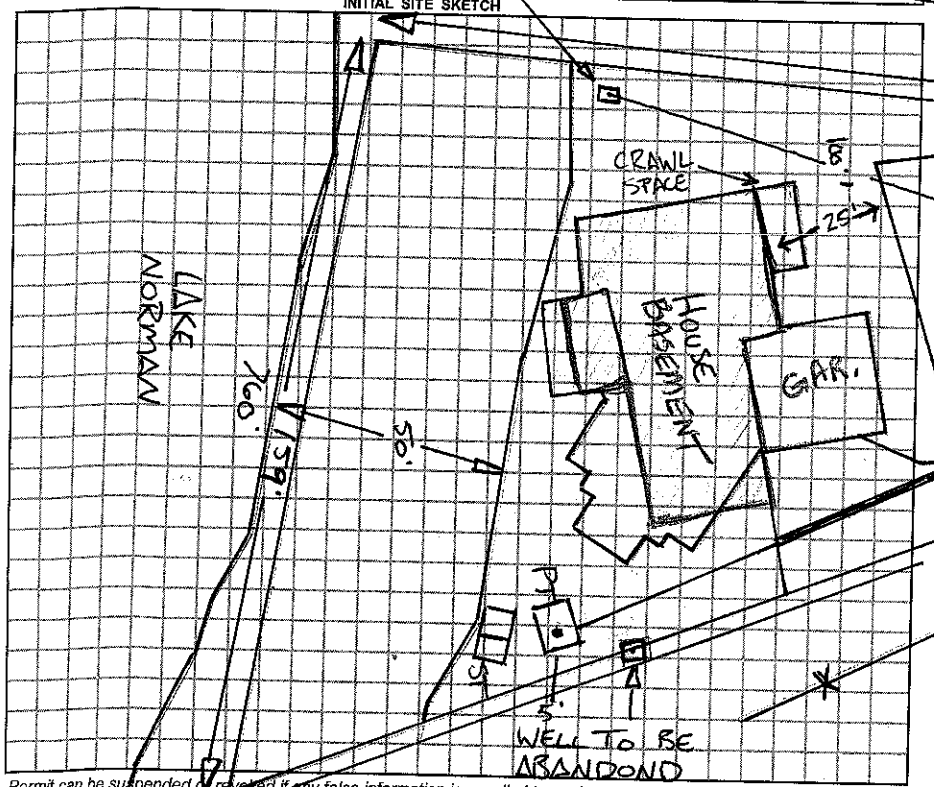

AS BUILT SKETCH

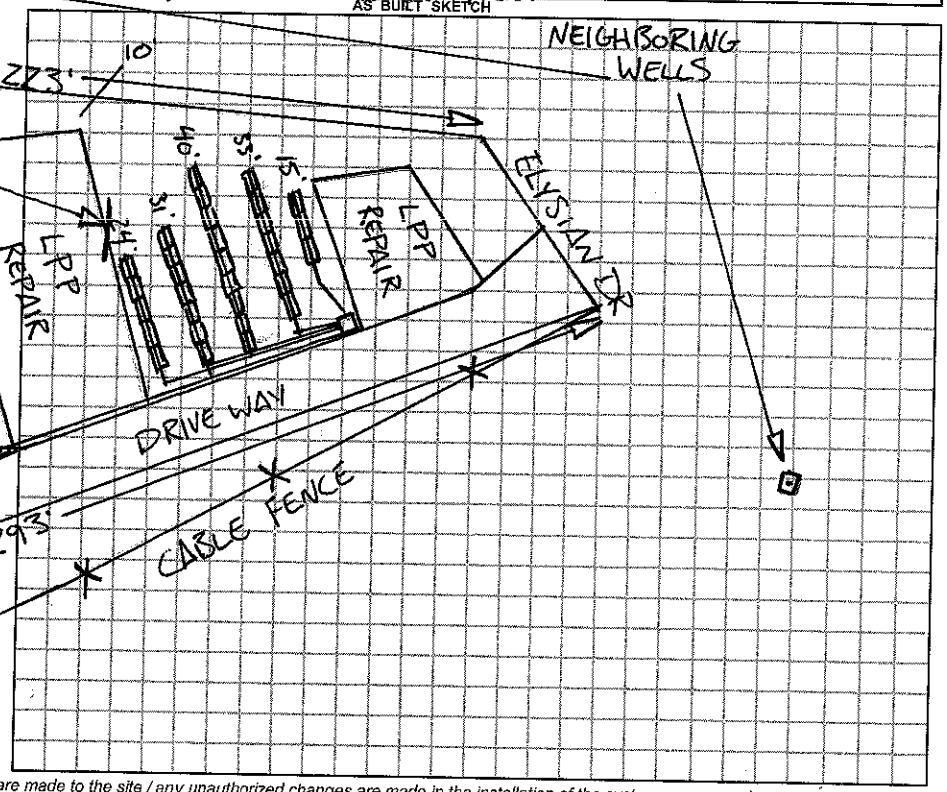

Permit can be suspended or revoked if any false information is supplied toward securing the permit / any unauthorized changes are made to the site / any unauthorized changes are made in the installation of the system.

☐ IMPROVEMENT PERMIT w / plat valid without expiration ☒ IMPROVEMENT PERMIT w / site plan valid for 60 mos.

☐ AUTHORIZATION TO CONSTRUCT valid for period equal to IMPROVEMENT PERMIT-not to exceed 60 mo.

Owner / Applicant Signature: [signature] Date 4-21-10

Improvement Permit by: [signature] REHS Date 4-20-10

Authorzation to Construct by: [signature] REHS Date 11-24-10

YOU SHOULD CONTACT A LOCATOR SERVICE PRIOR TO ANY EXCAVATION.

Installed by: Willie [illegible] RS

Operation Permit by: [signature] Date 10/19/2011

Existing System Inspected by: Date:

WHITE COPY Environmental Health YELLOW COPY (Final) Owner / Applicant PINK COPY (Initial) Owner / Applicant