IREDELL COUNTY HEALTH DEPARTMENT

STATESVILLE 704-878-5305 MOORESVILLE 704-664-5281

IMPROVEMENT PERMIT / AUTHORIZATION TO CONSTRUCT / OPERATION PERMIT / EXISTING SYSTEM INSPECTION

1618 7

PERMIT# 07871/16187 PIN# ~~4646-35-5649~~ ~~4646-35-6549~~ 4646-35-6549 DATE 7/12/01

OWNER OR CONTRACTOR J+J Brotherton PHONE: Business _____ Home 704-663-2300

ADDRESS 270 Candlewick Rd Mooresville, NC. 28117

LOCATION 150 W TL Williamson Rd (R) on Sundown, (L) on Elysian, ~ 1/4 mile on (R)

SUBDIVISION Moreland Estates BLOCK / SECTION _____ LOT 14 LOT AREA .59 SITE CLASS. PS DESIGN FLOW 480 L.T.A.R. .3

Septic Tank: 1000 Gallons; STB 1007 Date 6/11/05

Pump Tank: _____ Gallons; PT _____ Date _____

Pump Make: _____ Model _____ Serial No. _____

Nitrification Field: No Fields 1 Square Feet 800 Linear Feet 267

No Lines 3@89' Trench Width 2-3' Max Trench Bottom Depth 3' Gravel Depth SAND/Rock

☒ New System ☐ Repair System Type: I, II, (III), IV, V, VI

System Description: ERAY - 16" APBS

Repair System Description: < 1983 PLAT

Maintenance Agreement Required: ☐ Yes ☒ No

☒ House/Mod. Home No. Bedrooms 4@

☐ Mobile Home No. Bathrooms 3

☐ Business No. Employees _____

☐ Other _____

☐ Slab ☐ Crawl Space ☒ Basement w/plumbing ☐ Basement wo/plumbing


Water Supply: ☒ Individual ☐ Public ☐ Community

Comments:/Conditions: 10/31/03 - use drop boxes on Flow Divider and 2 Dist Boxes to Center Feed - this trench Dr. - AWS

Comments:/Conditions:

(1" = 50')

INITIAL SITE SKETCH

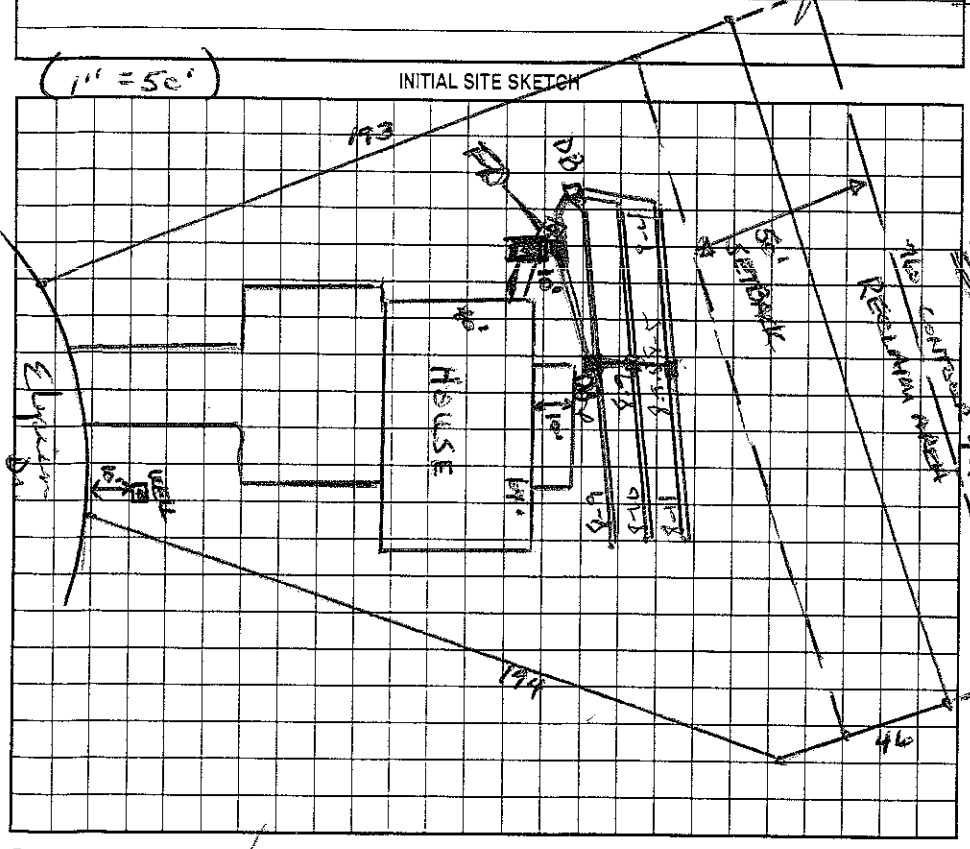

AS BUILT SKETCH

Permit can be suspended or revoked if any false information is supplied toward securing the permit/any unauthorized changes are made to the site/any unauthorized changes are made in the installation of the system. Improvement Permit with plat valid without expiration. Improvement Permit with site plan valid for sixty months. Authorization to Construct is valid for a period equal to that of Improvement Permit – not to exceed sixty months.

Signed: * J+J Brotherton date _____ Installed by: Wayne Pentz

Improvement Permit by: Wesley Sparks RS. date 7/12/01 Operation Permit by: Wesley Sparks RS date 12/22/05

Authorization to Construct by: Wesley Sparks RS. date 7/12/01 Existing System Inspection by: _____ date _____

HEALTH DEPT. COPY: WHITE OWNER COPY (FINAL): YELLOW OWNER COPY (INITIAL): PINK