IREDELL COUNTY HEALTH DEPARTMENT

Statesville Office (704) 878-5305 Mooresville Office (704) 660-3625 PERMIT # 177230

IMPROVEMENT PERMIT / AUTHORIZATION TO CONSTRUCT / OPERATION PERMIT / EXISTING SYSTEM

PIN # 4646358645

APPLICANT: Jeffrey Brotherton APPLICANT ADDRESS: 154 Elysian Dr Mooresville, NC 28117

SITE ADDRESS: 154 Elysian Dr M'ville NC 28117 PHONE: ALT. PHONE:

SITE DIRECTIONS: Williamson Rd (from Brawley School Rd) TR Sundown Tl Elysian Dr ~1/4 mile on right

SUBDIVISION: Mooreland Est. SECTION: LOT # 15 LOT AREA: DESIGN FLOW: 360 gpd L.T.A.R.:

Septic Tank 1000 (gal) STB Date

Pump Tank (gal) PT Date

Pump Make Model Serial #

Nitrification Fields 1 # Lines 2 Linear Ft: 225

Trench Width Bed Max. Trench Bottom Depth Gravel Depth 10"

☐ New System ☐ Repair ☐ Expansion System Type: ☐ I ☒ II ☐ III ☐ IV ☐ V ☐ VI

System Description: Existing Gravity Conventional

Repair System Description:

Maintenance Agreement Required: ☐ YES ☒ NO

☒ GRAVITY ☐ PRESSURE

☒ Residence No. Bedrooms 3

☐ Business No. Persons

☐ Other No. Employees

☐ Slab ☐ Crawl Space

☐ Basement w/plumbing ☐ Basement w/o plumbing


Water Supply: ☒ Private ☐ Public ☐ Community

Comments / Conditions:

Septic System originally Sized for 3 Bedrooms; Number of Bedrooms will remain 3. Existing Buildings are >5ft from Septic System

INITIAL SITE SKETCH

AS BUILT SKETCH

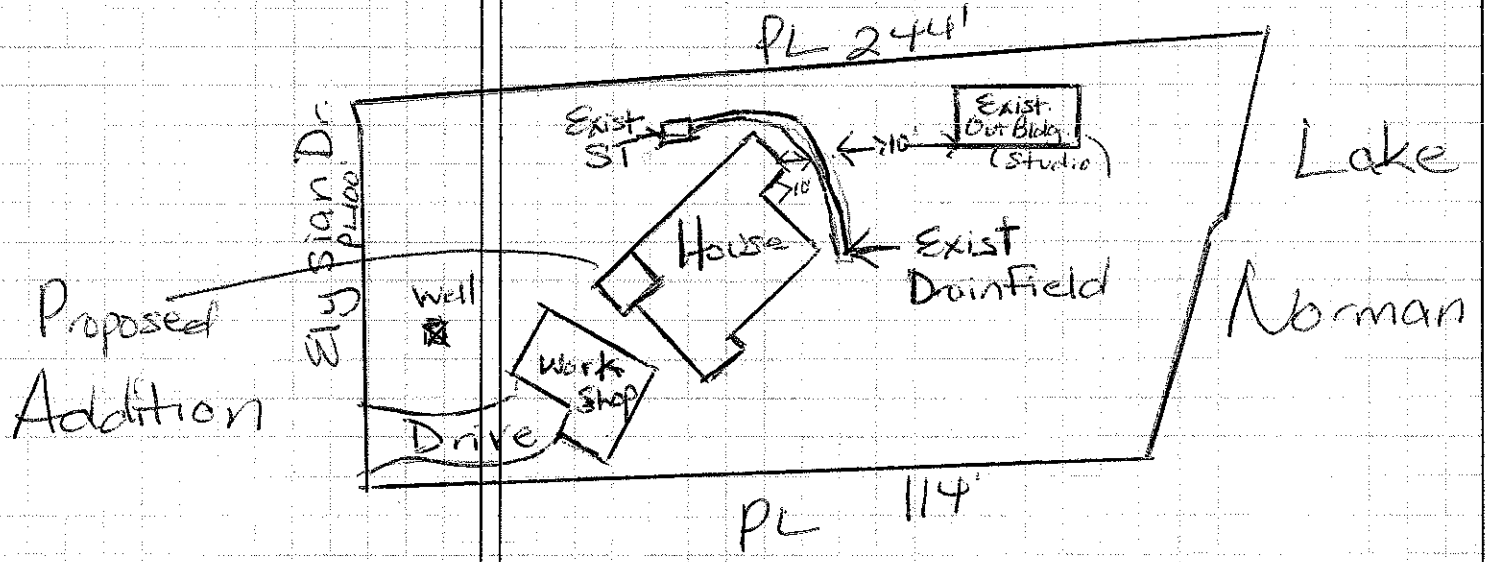

Permit can be suspended or revoked if any false information is supplied toward securing the permit / any unauthorized changes are made to the site / any una

☐ **IMPROVEMENT PERMIT** *with plat valid without expiration.* ☐ **IMPROVEMENT PERMIT** *with site plan valid for 60 mos.*

Y EXCAVATION *xceed 60 mo.*

Location of the proposed 12'x16' Addition addition does not appear to impact the existing on-site septic system.**NOTE: Keep all Buildings at least 5Ft from Septic & 25 ft to well

Owner / Applicant Signature: Date: Installed by:

IMPROVEMENT PERMIT by: Date: OPERATION P

AUTHORIZATION TO CONSTRUCT by: Date: Existing Syst

Maria Robertson REHS

Date: 4/2/13

ICHD-Environmental Health Division

Health Dept. Copy - WHITE Applicant (Final Approval) - YELLOW Applicant (Conditional Approval) - PINK