IREDELL COUNTY HEALTH DEPARTMENT

Authorization to Construct

STATESVILLE 704-878-5305 MOORESVILLE 704-664-5281

IMPROVEMENT PERMIT / ~~CERTIFICATE OF COMPLETION~~ / OPERATION PERMIT / EXISTING SYSTEM INSPECTION

PROPERTY DESCRIPTION NO. 22385 DATE 12/18/95 TAX MAP NO. 2J 5 A 28 Watershed: ☐ Yes ☒ No

OWNER OR CONTRACTOR Larry + Nettie Damrell PHONE: Business 4044-36-4544 Home 663-2600

ADDRESS 115 Elysian Dr. Mooresville NC 28115

LOCATION Sundown Rd., TL Elysian Rd. Lot on (L) before Zephyr Ln.

SUBDIVISION Moorland Est BLOCK / SECTION ____ LOT Lot 6 LOT AREA .79 SITE CLASS. PS DESIGN FLOW 360 L.T.A.R. .35

Septic Tank: 1000 Gallons; STB 794 Date 7/15/96

Pump Tank: ____ Gallons; PT ____ Date ____

Pump Make: ____ Model ____ Serial No. ____

Nitrification Field: No Fields 1 Square Feet 1028 Linear Feet 342 *

No Lines 3 Trench Width 36" Max Trench Bottom Depth 36" Gravel Depth SAND

☒ New System ☐ Repair System Type: I, II, (III) IV, V, VI

System Description: GRAVITY - INFILTRATOR

Repair System Description: SAME

Maintenance Agreement Required: ☐ Yes ☒ No

☒ House/Mod. Home No. Bedrooms 3

☐ Mobile Home No. Bathrooms 2

☐ Business No. Employees ____

☐ Other ____


☐ Slab ☒ Crawl Space ☐ Basement w/plumbing ☐ Basement wo/plumbing

Water Supply: ☒ Individual ☐ Community ☐ Public

Comments: 257' of Gravity Infiltrator Panel may be used.

Comments: ~~ARCHED~~ LOUVERS

INITIAL SITE SKETCH

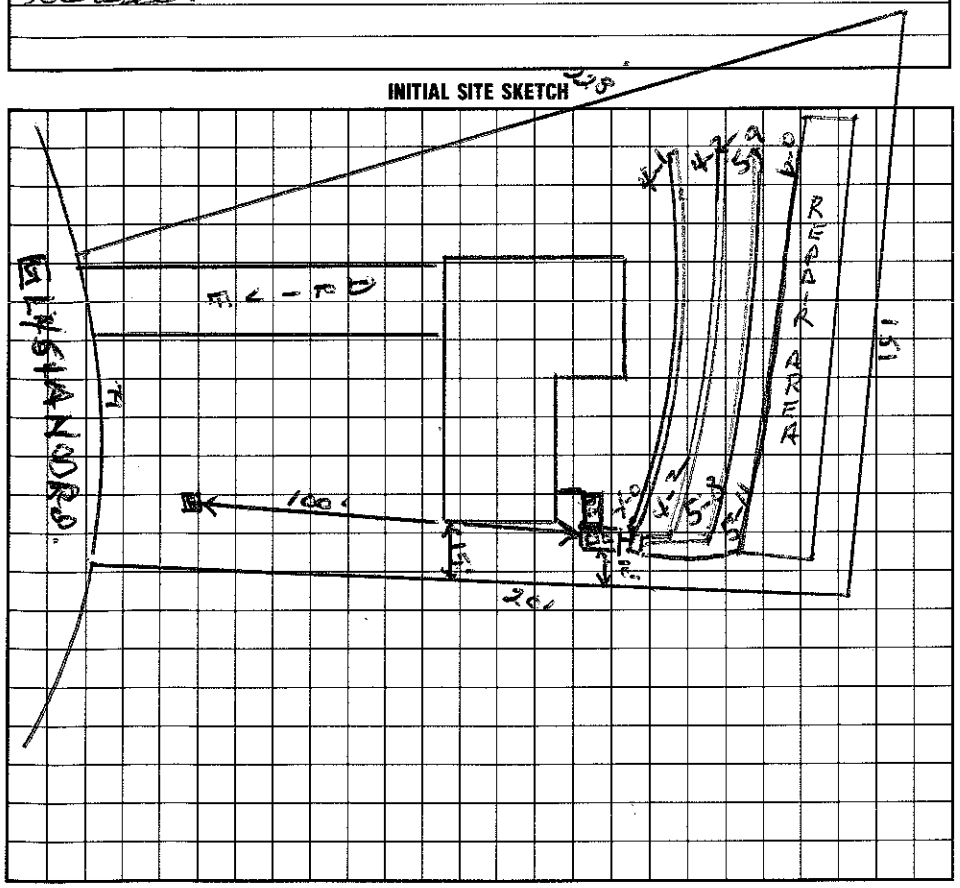

AS BUILT SKETCH

I understand that this permit can be suspended or revoked if any false information is supplied toward securing the permit/any unauthorized changes are made to the site/any unauthorized changes are made in the installation of the system.

Signed: x Nettie N. Damrill

Improvement Permit by: Wesley Sparks R.S. date 12/18/95

Authorization to Construct: Wesley Sparks R.S. date 12/18/95

Existing System Inspection by: ____ date ____

Installed by: Julian Bowles

Certificate of Completion by: ____ date ____

Operation Permit by: Wesley Sparks R.S. date 9/27/96

HEALTH DEPT. COPY: WHITE INSPECTION COPY (FINAL): GREEN OWNER COPY (FINAL): YELLOW INSPECTION COPY (INITIAL): PINK OWNER COPY (INITIAL): GOLD