[illegible] COUNTY HEALTH DEPARTMENT

$1300

STATESVILLE 704-878-5305 MOORESVILLE 704-664-5281

IMPROVEMENT PERMIT / AUTHORIZATION TO CONSTRUCT / OPERATION PERMIT / EXISTING SYSTEM INSPECTION

PERMIT# 117535 PIN# 4646 36 5597 DATE 1/14/04

OWNER OR CONTRACTOR George Church PHONE: Business 704-400-9829 Home

ADDRESS 109 Harbor Cove Ln. Mooresville, NC 28117

LOCATION Zephyr Ln., Williamson Rd S TR Sundown Rd TL Elysian Dr, TL Zephyr Ln. 2nd lot on (L)

SUBDIVISION Mountain Ash BLOCK / SECTION LOT 5 LOT AREA .46Ac SITE CLASS PS DESIGN FLOW 360 L.T.A.R. .3

Septic Tank: 1000 Gallons; STB Date

Pump Tank: Gallons; PT Date

Pump Make: Model Serial No.

Nitrification Field: No Fields 1 Square Feet 400/600 Linear Feet 200

No Lines 4@50' Trench Width 2-3' Max Trench Bottom Depth 36" Gravel Depth No

[X] New System [ ] Repair System Type: I, II, III, IV, V, VI

System Description: LCAW174 - 16" ABBAS

Repair System Description: 473 Recording

Maintenance Agreement Required: [ ] Yes [X] No

[X] House/Mod. Home No. Bedrooms 3

[ ] Mobile Home No. Bathrooms 2.5

[ ] Business No. Employees

[ ] Other


[ ] Slab [X] Crawl Space [ ] Basement w/plumbing [ ] Basement wo/plumbing

Water Supply: [X] Individual [ ] Public [ ] Community


Comments/Conditions: 2' on 8' Centers; 3' on 9' Centers.
Keep on contour in direction shown.
VERY TIGHT

Comments/Conditions:

INITIAL SITE SKETCH

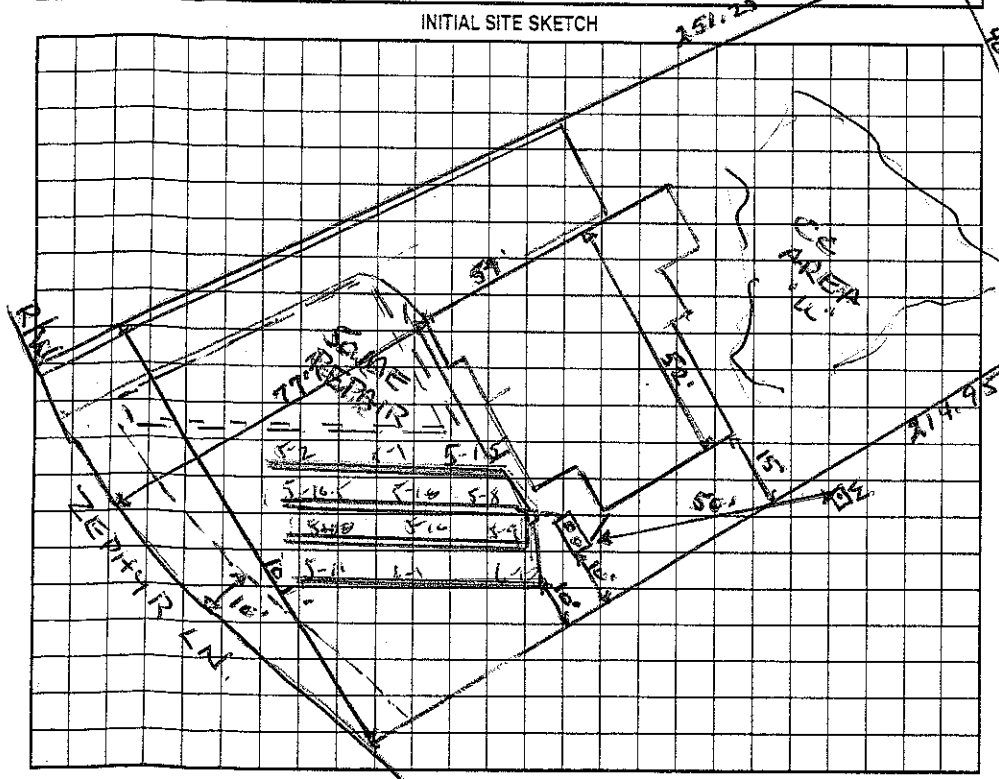

AS BUILT SKETCH

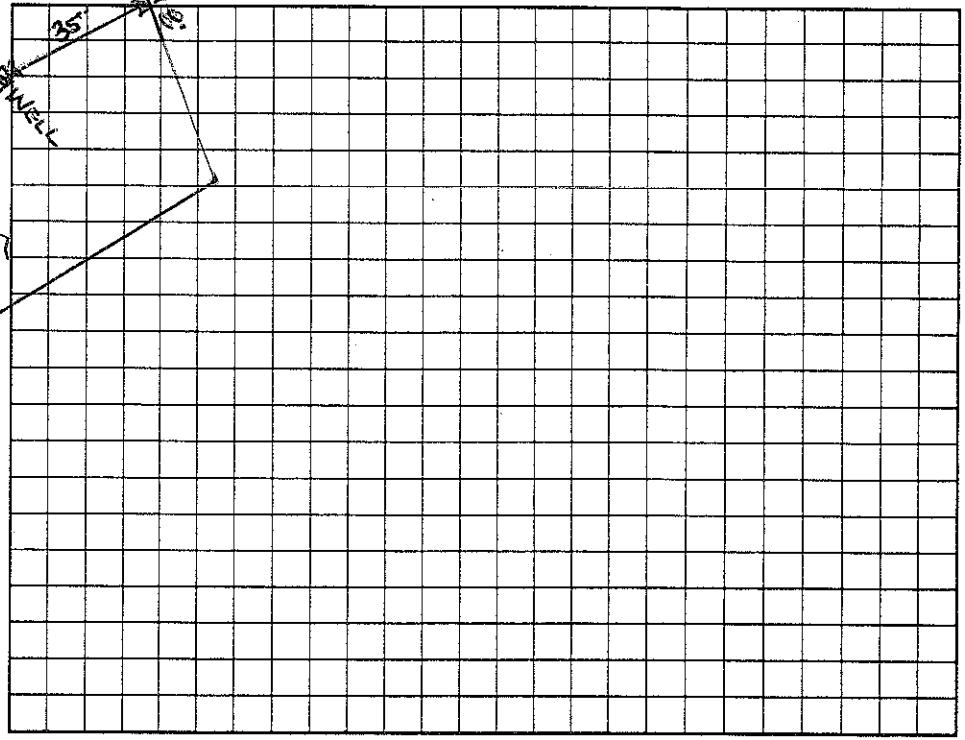

Permit can be suspended or revoked if any false information is supplied toward securing the permit/any unauthorized changes are made to the site/any unauthorized changes are made in the installation of the system. Improvement Permit with plat valid without expiration. Improvement Permit with site plan valid for sixty months. Authorization to Construct is valid for a period equal to that of Improvement Permit – not to exceed sixty months.

Signed: George Church date

Improvement Permit by: Wesley Sparks RS date 1/14/04

Authorization to Construct by: Wesley Sparks RS date 1/14/04

Installed by: Joe Perkins

Operation Permit by: Wesley Sparks RS date 10/1/04

Existing System Inspection by: date

HEALTH DEPT. COPY: WHITE OWNER COPY (FINAL): YELLOW OWNER COPY (INITIAL): PINK