IREDELL COUNTY HEALTH DEPARTMENT

ST ...LLE 704-878-5305 [redacted] MOORESVILLE 704-6... 81

IMPROVEMENT PERMIT / AUTHORIZATION TO CONSTRUCT / OPERATION PERMIT / EXISTING SYSTEM INSPECTION

PERMIT# 087672 PIN# 4646 36 6874 DATE 3/3/00

OWNER OR CONTRACTOR James McNeill PHONE: Business 799-2101 Home

ADDRESS 159 Walmsley Pl. Mooresville, NC. 28117

LOCATION 1109 TR Sundown Rd. TL Brockway TR Moore Land to cul de sac, lot straight ahead off cul de sac

SUBDIVISION Idlewood Harbor BLOCK / SECTION LOT 96 LOT AREA .6 SITE CLASS. PS DESIGN FLOW 360 L.T.A.R. .3

Septic Tank: 1000 Gallons; STB [redacted] Date 7/14/00
Pump Tank: Gallons; PT Date
Pump Make: Model Serial No.
Nitrification Field: No Fields 1 Square Feet 900 * Linear Feet 300 *
No Lines 5@60'x3' Trench Width 36" Max Trench Bottom Depth 36" ~~Gravel Depth~~ SAND.

☒ New System ☐ Repair System Type: I, II, III, IV, V, VI
System Description: 25% Reduction - EZ LAY 6 CH. PLUS
Repair System Description: <83 Platted
Maintenance Agreement Required: ☐ Yes ☒ No


☒ House/Mod. Home No. Bedrooms 3
☐ Mobile Home No. Bathrooms 2
☐ Business No. Employees
☐ Other
☐ Slab ☒ Crawl Space ☐ Basement w/plumbing ☐ Basement wo/plumbing

Water Supply:
☒ Individual
☐ Public
☐ Community

Comments:/Conditions:


204

INITIAL SITE SKETCH

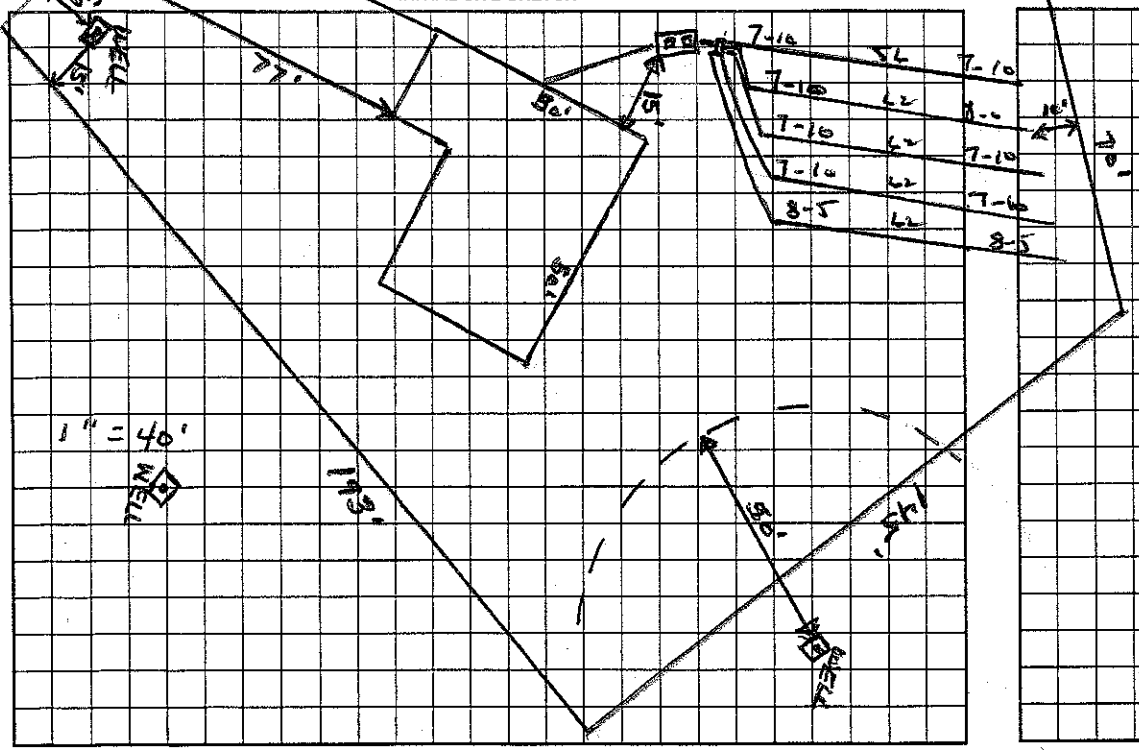

Comments:/Conditions:

AS BUILT SKETCH

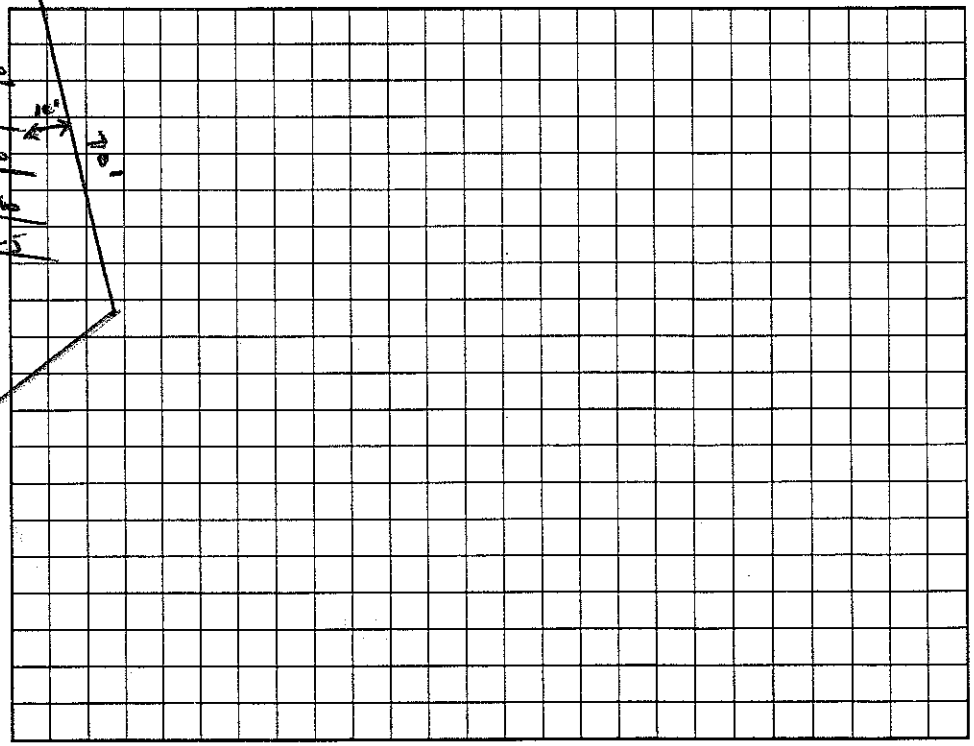

Permit can be suspended or revoked if any false information is supplied toward securing the permit/any unauthorized changes are made to the site/any unauthorized changes are made in the installation of the system. Improvement Permit with plat valid without expiration. Improvement Permit with site plan valid for sixty months. Authorization to Construct is valid for a period equal to that of Improvement Permit – not to exceed sixty months.

Signed: X J.N. McNeill date 3/7/00

Improvement Permit by: Wesley Sparks RS. date 3/3/00

Authorization to Construct by: Wesley Sparks RS. date 3/3/00

Installed by: Richard Abernathy

Operation Permit by: Wesley Sparks RS date 9/11/00

Existing System Inspection by: date

HEALTH DEPT. COPY: WHITE OWNER COPY (FINAL): YELLOW OWNER COPY (INITIAL): PINK