IREDELL COUNTY HEALTH DEPARTMENT

STATESVILLE 704-878-5305 MOORESVILLE 704-664-5281

IMPROVEMENT PERMIT / AUTHORIZATION TO CONSTRUCT / OPERATION PERMIT / EXISTING SYSTEM INSPECTION

PERMIT# 087673 PIN# 4646 36 4996 DATE 3/3/00

OWNER OR CONTRACTOR James McNeill PHONE: Business 799-2101 Home

ADDRESS 159 Walmsley Pl. Mooresville, NC. 28115

LOCATION 1109 TR Sundown Rd. TL Brockway TR Moreland at culdesac on (L)

SUBDIVISION IDLEWOOD HARBOR BLOCK / SECTION LOT 95 LOT AREA .6 AC SITE CLASS PS DESIGN FLOW 360 L.T.A.R. .3

Septic Tank: 1000 Gallons; STB 1012 Date 7/14/00
Pump Tank: Gallons; PT Date
Pump Make: Model Serial No.
Nitrification Field: No Fields 1 Square Feet 900 * Linear Feet 300 *
No Lines 4 @ 75' K3' Trench Width 36" Max Trench Bottom Depth 36" ~~Gravel Depth~~ SAND

[X] New System [ ] Repair System Type: I, II, (III) IV, V, VI
System Description: 25% Red. - EZFLOW OR CH. PLAS.
Repair System Description: PLATED < 1982
Maintenance Agreement Required: [ ] Yes [X] No


[X] House/Mod. Home No. Bedrooms 3
[ ] Mobile Home No. Bathrooms 2.5
[ ] Business No. Employees
[ ] Other

[ ] Slab [X] Crawl Space [ ] Basement w/plumbing [ ] Basement wo/plumbing

Water Supply: [X] Individual [ ] Public [ ] Community

Comments/Conditions:

INITIAL SITE SKETCH

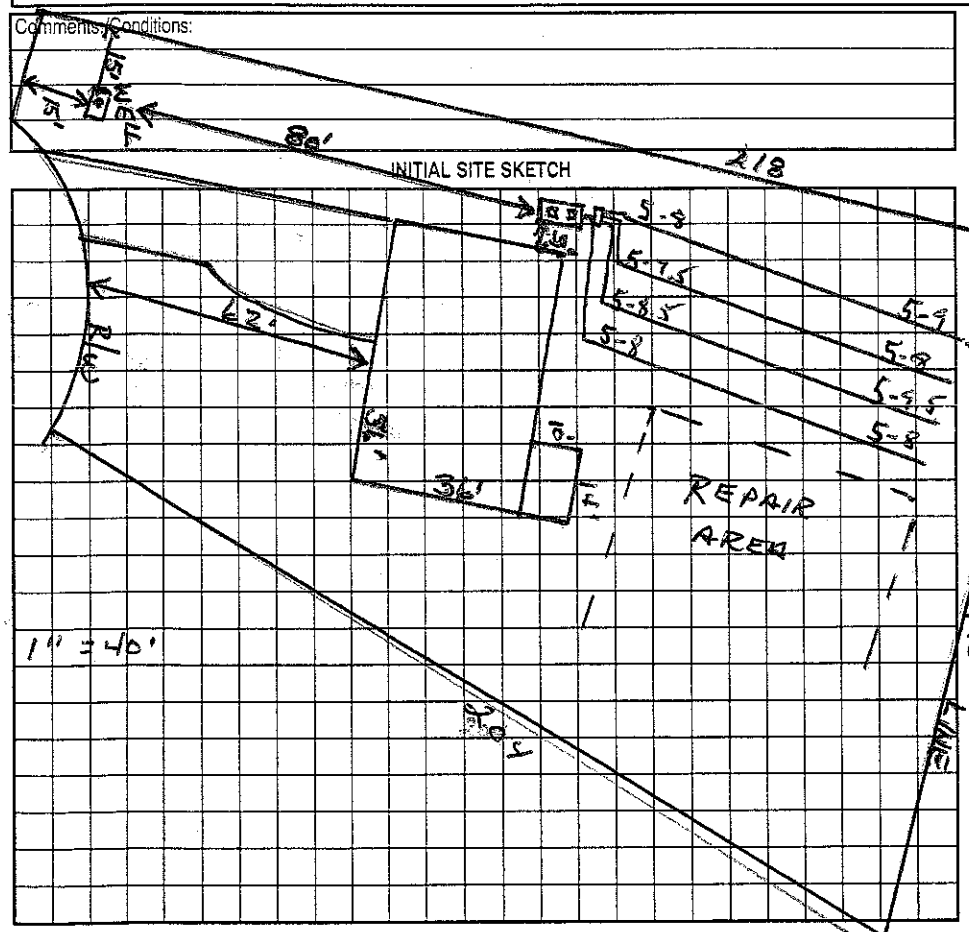

Comments/Conditions:

AS BUILT SKETCH

Permit can be suspended or revoked if any false information is supplied toward securing the permit/any unauthorized changes are made to the site/any unauthorized changes are made in the installation of the system. Improvement Permit with plat valid without expiration. Improvement Permit with site plan valid for sixty months. Authorization to Construct is valid for a period equal to that of Improvement Permit – not to exceed sixty months.

Signed: X J.M. McNeill date 3/7/00 Installed by: Richard Abernathy

Improvement Permit by: Wesley Sparks R.S. date 3/3/00 Operation Permit by: Wesley Sparks R.S. date 9/11/00

Authorization to Construct by: Wesley Sparks R.S. date 3/3/00 Existing System Inspection by: date

HEALTH DEPT. COPY: WHITE OWNER COPY (FINAL): YELLOW OWNER COPY (INITIAL): PINK