2:00 - 2:30

IREDELL COUNTY HEALTH DEPARTMENT

STATESVILLE 704-878-5305 MOORESVILLE 704-664-5281

IMPROVEMENT PERMIT / CERTIFICATE OF COMPLETION / OPERATION PERMIT / EXISTING SYSTEM INSPECTION

PROPERTY DESCRIPTION NO. 20655 DATE 5/12/95 TAX MAP NO. 2K B 27 Pt of Watershed: ☑ Yes ☐ No

OWNER OR CONTRACTOR Dennis Development LTD (Doug Kluttz) PHONE: Business 478-2752 ~~Home 463-7979 4846~~ 4646-37-6209

ADDRESS PO Box 44 Statesville Rd, NC 28673

LOCATION Sundown Rd TR on Shinecliff Dr. corner lot on R

SUBDIVISION Lake Vista BLOCK / SECTION ____ LOT 1 LOT AREA ~.64 SITE CLASS. P DESIGN FLOW 430 L.T.A.R. .35

Septic Tank: 1000 Gallons; STB 925 Date 7/11/96

Pump Tank: ____ Gallons; PT ____ Date ____

Pump Make: ____ Model ____ Serial No. ____

Nitrification Field: No Fields 1 Square Feet 1371 Linear Feet 340 *

No Lines 4 Trench Width 36" Max Trench Bottom Depth 34" Gravel Depth N/A

☑ New System ☐ Repair System Type: I, II, (III), IV, V, VI

System Description: Density - Infiltrator

Repair System Description: Level

Maintenance Agreement Required: ☐ Yes ☑ No

☐ House/Mod. Home No. Bedrooms 4

☐ Mobile Home No. Bathrooms 3

☐ Business No. Employees ____

☐ Other ____


☐ Slab ☑ Crawl Space ☐ Basement w/plumbing ☐ Basement wo/plumbing

Water Supply: ☑ Individual ☐ Community ☐ Public

Comments: * 25% Reduction for INFILTRATOR USE

Comments:

INITIAL SITE SKETCH

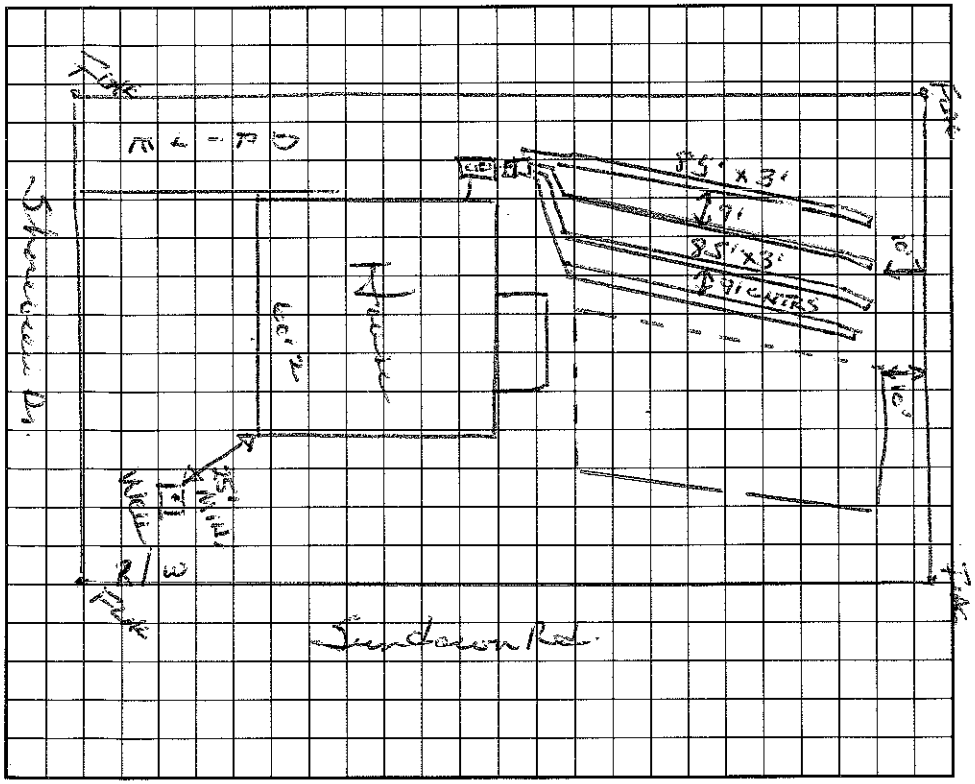

AS BUILT SKETCH

I understand that this permit can be suspended or revoked if any false information is supplied toward securing the permit/any unauthorized changes are made to the site/any unauthorized changes are made in the installation of the system. Improvement Permit is valid for 60 months from date of issuance.

Signed: [signature]

Improvement Permit by: Wesley Sparks R.S. date 5/12/95

Existing System Inspection by: ____ date ____

Installed by: CURT DUNNING

Certificate of Completion by: ____ date ____

Operation Permit by: [signature] EHS date 9/18/96

HEALTH DEPT. COPY: WHITE INSPECTION COPY (FINAL): GREEN OWNER COPY (FINAL): YELLOW INSPECTION COPY (INITIAL): PINK OWNER COPY (INITIAL): GOLD