1230

IREDELL COUNTY HEALTH DEPARTMENT

STATESVILLE 704-878-5305 MOORESVILLE 704-664-5281

IMPROVEMENT PERMIT / CERTIFICATE OF COMPLETION / OPERATION PERMIT / EXISTING SYSTEM INSPECTION

PROPERTY DESCRIPTION NO. _____ DATE 3-15-95 TAX MAP NO. 4646-37-2327 Watershed: ☑ Yes ☐ No

OWNER OR CONTRACTOR Michael K Lewis PHONE: Business _____ Home 663-6075

ADDRESS 259 Sundown Rd Mooresville 28115

LOCATION 150 W TL Williamston Rd TR Sundown approx 1½ mi left

SUBDIVISION Idlewood Harbor BLOCK / SECTION _____ LOT 118 LOT AREA 100'X200' SITE CLASS. PS DESIGN FLOW _____ L.T.A.R. .3 gpd/sq ft/day

Septic Tank: EX Gallons; STB _____ Date _____

Pump Tank: _____ Gallons; PT _____ Date _____

Pump Make: _____ Model _____ Serial No. _____

Nitrification Field: No Fields 2 Square Feet 450 Linear Feet 150

No Lines 2 Trench Width 36" Max Trench Bottom Depth 36" Gravel Depth 12"

☐ New System ☑ Repair System Type: I ☑ II, III, IV, V, VI

System Description: _____

Repair System Description: Conv. Gravity

Maintenance Agreement Required: ☐ Yes ☑ No

☑ House/Mod. Home No. Bedrooms 3

☐ Mobile Home No. Bathrooms 2

☐ Business No. Employees _____

☐ Other _____

☐ Slab ☑ Crawl Space ☐ Basement w/plumbing ☐ Basement wo/plumbing

Water Supply: ☑ Individual ☐ Community ☐ Public


Comments:

Drop boxes for new lines


Comments:

5/2/95 OK'd reworking DROP BOXES to get one for each, Initial - MLLS

INITIAL SITE SKETCH

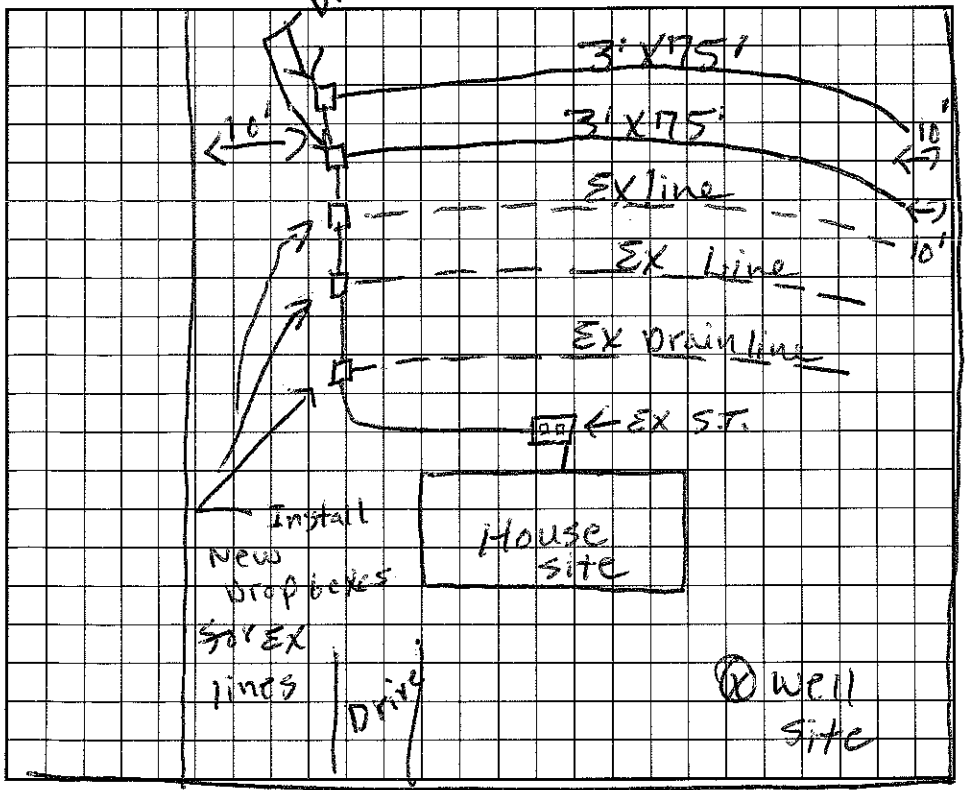

AS BUILT SKETCH

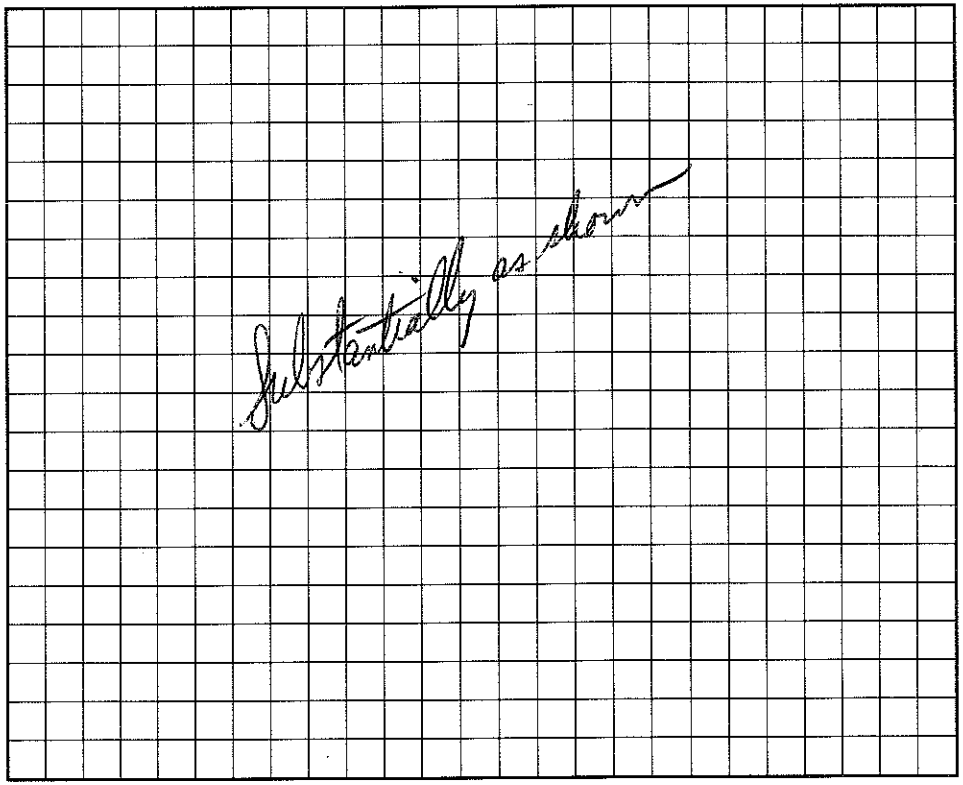

I understand that this permit can be suspended or revoked if any false information is supplied toward securing the permit/any unauthorized changes are made to the site/any unauthorized changes are made in the installation of the system. Improvement Permit is valid for 60 months from date of issuance.

Signed: Melba C. Lewis

Improvement Permit by: L. C. Moore date 3-15-95

Existing System Inspection by: _____ date _____

Installed by: Seymour (AAA Enterprises)

Certificate of Completion by: _____ date 5/3/95

Operation Permit by: _____ date _____

HEALTH DEPT. COPY: WHITE INSPECTION COPY (FINAL): GREEN OWNER COPY (FINAL): YELLOW INSPECTION COPY (INITIAL): PINK OWNER COPY (INITIAL): GOLD