IREDELL COUNTY HEALTH DEPARTMENT

STATESVILLE 704-878-5305 MOORESVILLE 704-664-5281

IMPROVEMENT PERMIT / AUTHORIZATION TO CONSTRUCT / OPERATION PERMIT / EXISTING SYSTEM INSPECTION

PERMIT# 116329 PIN# 4646-37-6789 DATE 10/30/03

OWNER OR CONTRACTOR Scott Needham PHONE: Business 704 365-9942 Home

ADDRESS 115 Peninsula Place Ln. Mooresville NC 28117

LOCATION Williamson, TR Sundown, TL Brockway, TR Moreland, on Lt. #135

SUBDIVISION Idlewood Harbor BLOCK / SECTION LOT 87 LOT AREA ± 0.5AC SITE CLASS. PS DESIGN FLOW 480 L.T.A.R. 0.5

Septic Tank: 1000 Gallons; STB 312 Date 4/14/04

Pump Tank: Gallons; PT Date

Pump Make: Model Serial No.

Nitrification Field: No Fields 1 Square Feet 1600 Linear Feet 530

No Lines 4 Trench Width 36" Max Trench Bottom Depth 36" Gravel Depth 12"

☒ New System ☐ Repair System Type: I (II) III, IV, V, VI

System Description: Gravity Conventional

Repair System Description: LP Panel Block

Maintenance Agreement Required: ☐ Yes ☒ No

☒ House/Mod. Home No. Bedrooms 4

☐ Mobile Home No. Bathrooms 2.5

☐ Business No. Employees

☐ Other

☐ Slab ☒ Crawl Space ☐ Basement w/plumbing ☐ Basement wo/plumbing


Water Supply: ☒ Individual ☐ Public ☐ Community

Comments:/Conditions:


1" = 40'

Comments:/Conditions:

INITIAL SITE SKETCH

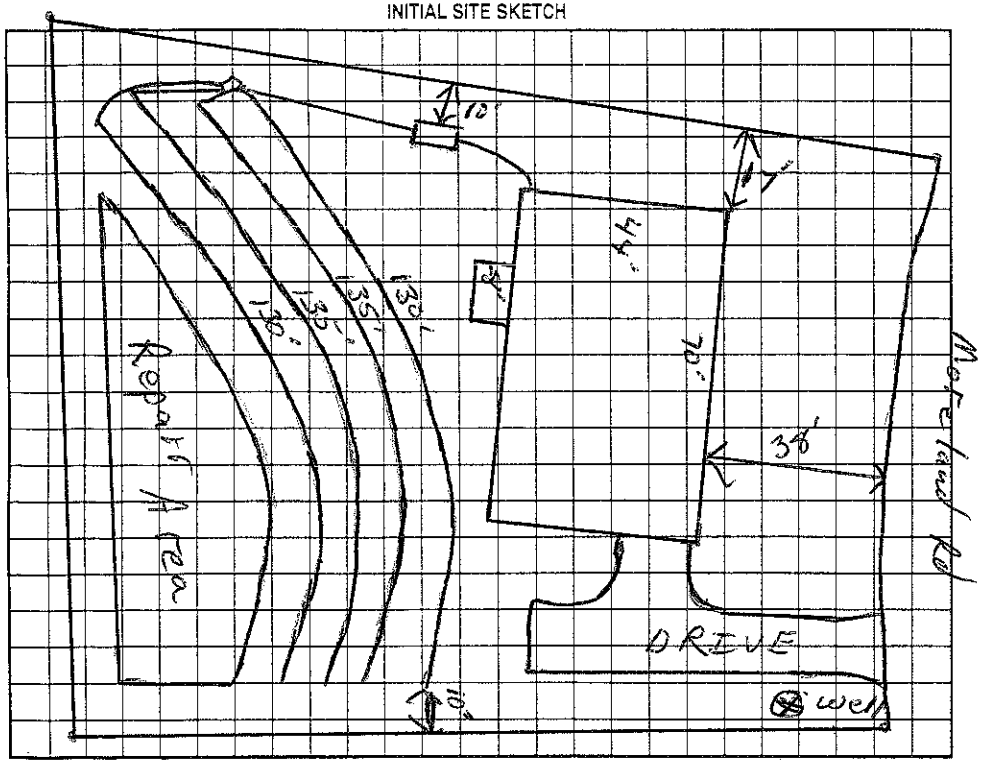

AS BUILT SKETCH

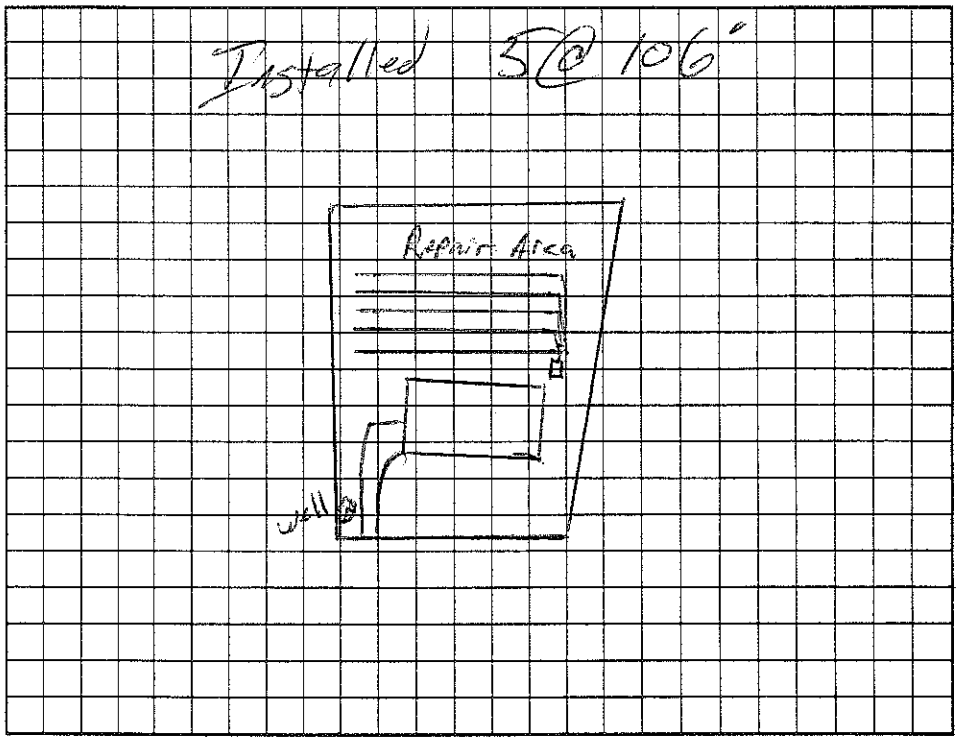

Permit can be suspended or revoked if any false information is supplied toward securing the permit/any unauthorized changes are made to the site/any unauthorized changes are made in the installation of the system. Improvement Permit with plat valid without expiration. Improvement Permit with site plan valid for sixty months. Authorization to Construct is valid for a period equal to that of Improvement Permit – not to exceed sixty months.

Signed: Scott R. Needham date 11/4/03

Improvement Permit by: RS date 10/30/03

Authorization to Construct by: RS date 10/30/03

Installed by: FJ Ervin

Operation Permit by: RS date 5/20/04

Existing System Inspection by: date

HEALTH DEPT. COPY: WHITE OWNER COPY (FINAL): YELLOW OWNER COPY (INITIAL): PINK