IREDELL COUNTY HEALTH DEPARTMENT

Authorization to Construct (1430)

STATESVILLE 704-878-5305 MOORESVILLE 704-664-5281

IMPROVEMENT PERMIT / ~~CERTIFICATE OF COMPLETION~~ / OPERATION PERMIT / EXISTING SYSTEM INSPECTION

PROPERTY DESCRIPTION NO. 23486 DATE 4/24/96 TAX MAP NO. 2J 10A 84 Watershed: [X] Yes [ ] No

OWNER OR CONTRACTOR C W Brewer Jr. PHONE: Business 663-4669 ~~Home~~ 464-38-5116

ADDRESS PO Box 69 Mt Mourne, NC. 28123

LOCATION Moreland Dr. Sundown TL Brockway TR Moreland to 2nd lot on (L)

SUBDIVISION Idlewood Harbor BLOCK / SECTION ____ LOT 84 LOT AREA 21780 SITE CLASS. PS DESIGN FLOW 360 L.T.A.R. .3

Septic Tank: 1000 Gallons; STB 1012 Date 8/10/97
Pump Tank: ____ Gallons; PT ____ Date ____
Pump Make: ____ Model ____ Serial No. ____
Nitrification Field: No Fields 1 Square Feet 1200 Linear Feet 400
No Lines 4 Trench Width 36" Max Trench Bottom Depth 30-32" Gravel Depth 12"

[X] New System [ ] Repair System Type: I. (II) III. IV. V. VI
System Description: Conventional - Dist Box
Repair System Description: Gravity Panel
Maintenance Agreement Required: [ ] Yes [ ] No


[X] House/Mod. Home No. Bedrooms 3
[ ] Mobile Home No. Bathrooms 2
[ ] Business No. Employees ____
[ ] Other ____
[ ] Slab [X] Crawl Space [ ] Basement w/plumbing [ ] Basement wo/plumbing

Water Supply:
[X] Individual
[ ] Community
[ ] Public


Comments: House moved to minimum set back from road R/W in order to have conventional repair area.

Comments:

INITIAL SITE SKETCH

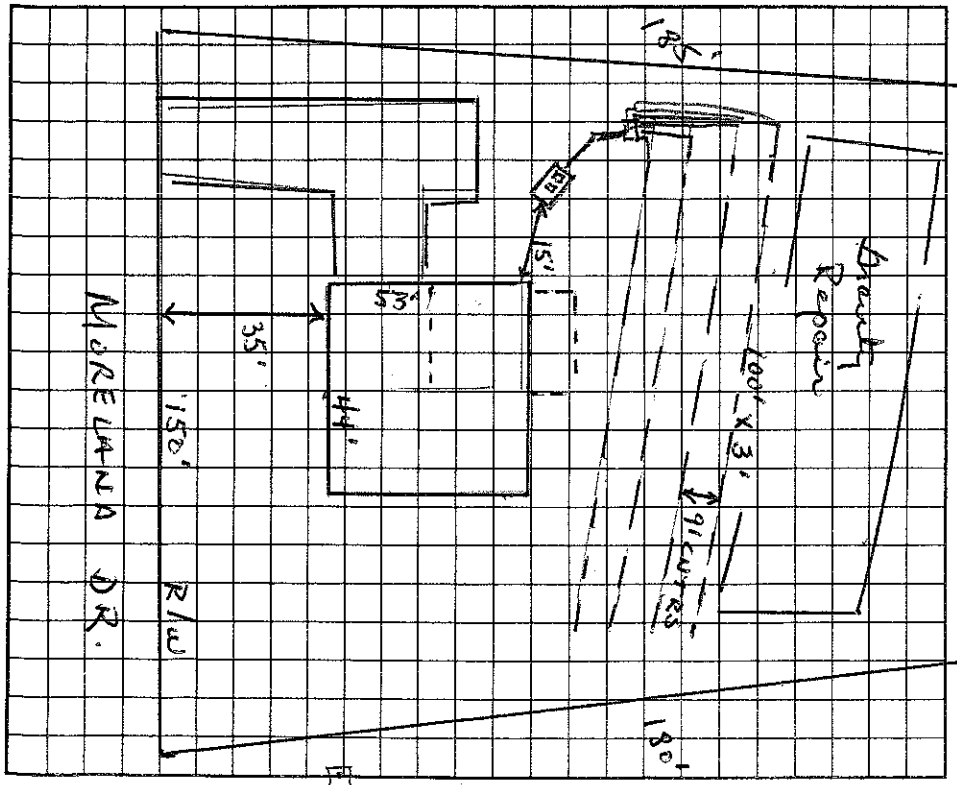

AS BUILT SKETCH

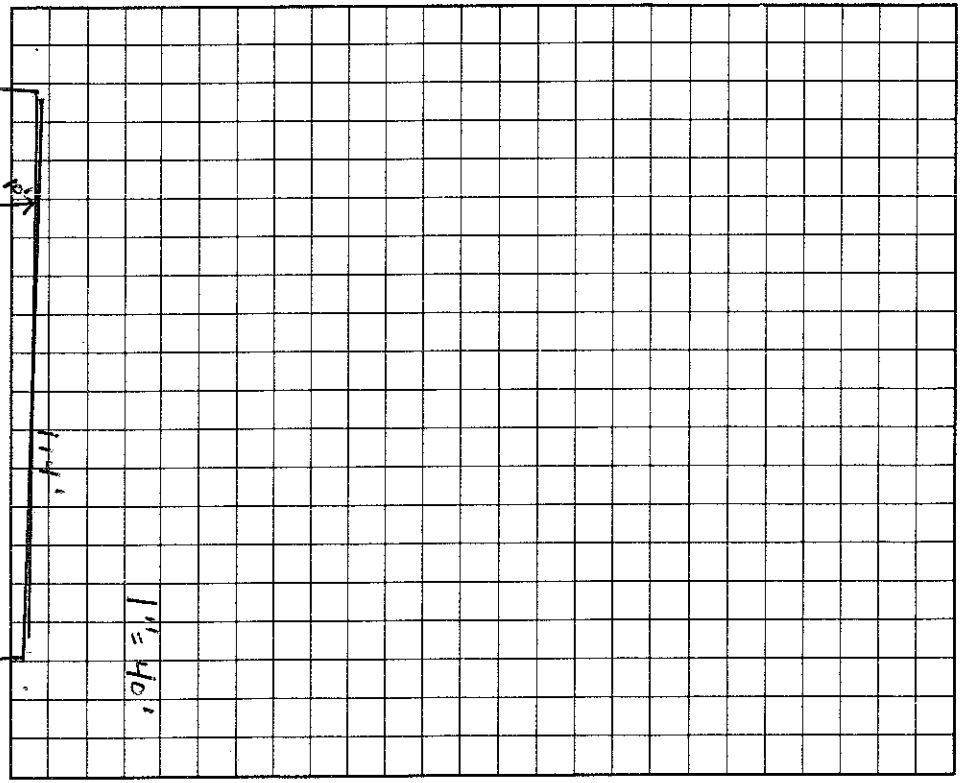

I understand that this permit can be suspended or revoked if any false information is supplied toward securing the permit/any unauthorized changes are made to the site/any unauthorized changes are made in the installation of the system.

Authorization to Construct valid 5 years

Signed: Jane Buchanan

Installed by: ABERNATHY

Improvement Permit by: ____ date ____

Existing System Inspection by: Authorization to Construct: Wesley Sparks RS date 4/24/96

Certificate of Completion by: ____ date ____

Operation Permit by: C. [illegible] date 11/6/97

HEALTH DEPT. COPY: WHITE INSPECTION COPY (FINAL): GREEN OWNER COPY (FINAL): YELLOW INSPECTION COPY (INITIAL): PINK OWNER COPY (INITIAL): GOLD