IREDELL COUNTY HEALTH DEPARTMENT

STATESVILLE 704-878-5305 175.00 Paid MOORESVILLE 704-664-5281

IMPROVEMENT PERMIT / AUTHORIZATION TO CONSTRUCT / OPERATION PERMIT / EXISTING SYSTEM INSPECTI

PERMIT# 103007 70 PIN# 4644 385393 Ken - ABJ DATE 10-24-2001

OWNER OR CONTRACTOR Jay Costa / ABJ Const. PHONE: Business 664-4353 Home

ADDRESS 109 Brookwood Dr. Mooresville

LOCATION Williamson Rd TR Sundown TL Brookway on Right

SUBDIVISION Idlewood Harbor BLOCK / SECTION LOT 82 LOT AREA SITE CLASS. DESIGN FLOW 360 gpd L.T.A.R.

Install

Septic Tank: 1000 Gallons; STB 794 Date 9-1-01

Pump Tank: Gallons; PT Date

Pump Make: Model Serial No.

Existing

Nitrification Field: No Fields 1 Square Feet 750 Linear Feet 250

No Lines 3 Trench Width Max Trench Bottom Depth Gravel Depth 10"

☒ New System ☐ Repair System Type: I, II, III, IV, V, VI

System Description: Gravity - Convent

Repair System Description:

Maintenance Agreement Required: ☐ Yes ☐ No

☒ House/Mod. Home No. Bedrooms 3

☐ Mobile Home No. Bathrooms 2

☐ Business No. Employees

☐ Other


☐ Slab ☒ Crawl Space ☐ Basement w/plumbing ☐ Basement wo/plumbing

Water Supply: ☒ Individual ☐ Public ☐ Community

Comments/Conditions: Proposed addition will be over Existing Septic tank. "Properly abandad" existing ST & install a New one At least 10' from PL & at least 5' to House

Comments/Conditions: Note: Existing D-box was Uncovered & was installed deep; drainlines also deep 40" or greater

INITIAL SITE SKETCH

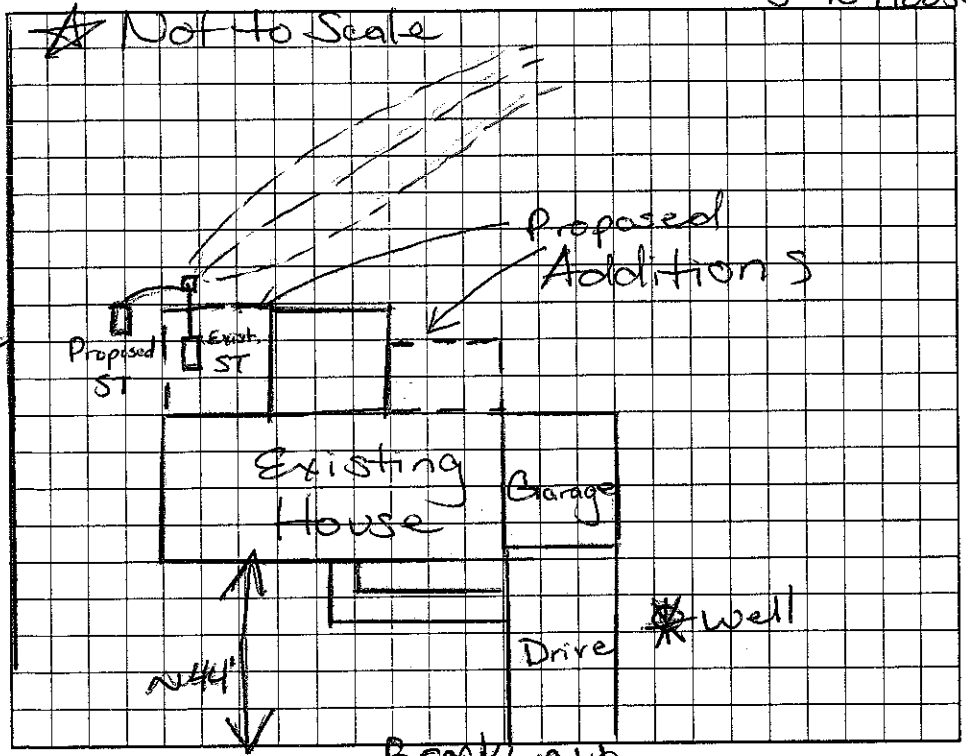

AS BUILT SKETCH

Permit can be suspended or revoked if any false information is supplied toward securing the permit/any unauthorized changes are made to the site/any unauthorized changes are made in the installation of the system. Improvement Permit with plat valid without expiration. Improvement Permit with site plan valid for sixty months. Authorization to Construct is valid for a period equal to that of Improvement Permit – not to exceed sixty months.

Signed ABJ By [signature] date 10-25-01 Installed by: F J Ervin

Improvement Permit by: Maina H. Dotson RS date 10/24/2001 Operation Permit by: Maina H. Dotson RS date 11/5/2001

Authorization to Construct by: Maina H. Dotson RS date 10/24/2001 Existing System Inspection by: date

HEALTH DEPT. COPY: WHITE OWNER COPY (FINAL): YELLOW OWNER COPY (INITIAL): PINK