Paid 125.00 DT 1100 - 1130

IREDELL COUNTY HEALTH DEPARTMENT

STATESVILLE 704-878-5305 MOORESVILLE 704-664-3281

IMPROVEMENT PERMIT / AUTHORIZATION TO CONSTRUCT / OPERATION PERMIT / EXISTING SYSTEM INSPECTION

PERMIT# 087674 PIN# 4646 38 5548 DATE 3/8/00

OWNER OR CONTRACTOR James McNeill PHONE: Business 799-2101 Home

ADDRESS 159 Walmsley Pl. Mooresville, NC. 28115

LOCATION 1109 TR Sundown TL Brockway, 3RD lot on (L)

SUBDIVISION IDELWOOD HARBOR BLOCK / SECTION LOT 55! LOT AREA ~.64c SITE CLASS. PS DESIGN FLOW 360 L.T.A.R. .3

Septic Tank: 1000 Gallons; STB 1012 Date 8-31-00 [X] New System [ ] Repair System Type: I, II, (III) IV, V, VI [X] House/Mod. Home No. Bedrooms 3

Pump Tank: Gallons; PT Date [ ] Mobile Home No. Bathrooms 2

Pump Make: Model Serial No. [ ] Business No. Employees

Nitrification Field: No Fields 1 Square Feet *900 Linear Feet *300 [ ] Other

System Description: *HDS OR CHAM. PLASTIC

Repair System Description: 16" PPBS *

Maintenance Agreement Required: [ ] Yes [X] No


No Lines *4@75'x3' Trench Width 36" Max Trench Bottom Depth 36" ~~Gravel Depth~~ SAND. [ ] Slab [X] Crawl Space [ ] Basement w/plumbing [ ] Basement wo/plumbing

Water Supply: [X] Individual [ ] Public [ ] Community

Comments:/Conditions: * 25% Reduction figured - on Hall whats shown here. * * Platted prior to 1983 - 100% Repair area not required. Ans.

Comments:/Conditions: Polylok Filter

INITIAL SITE SKETCH (1"=50')

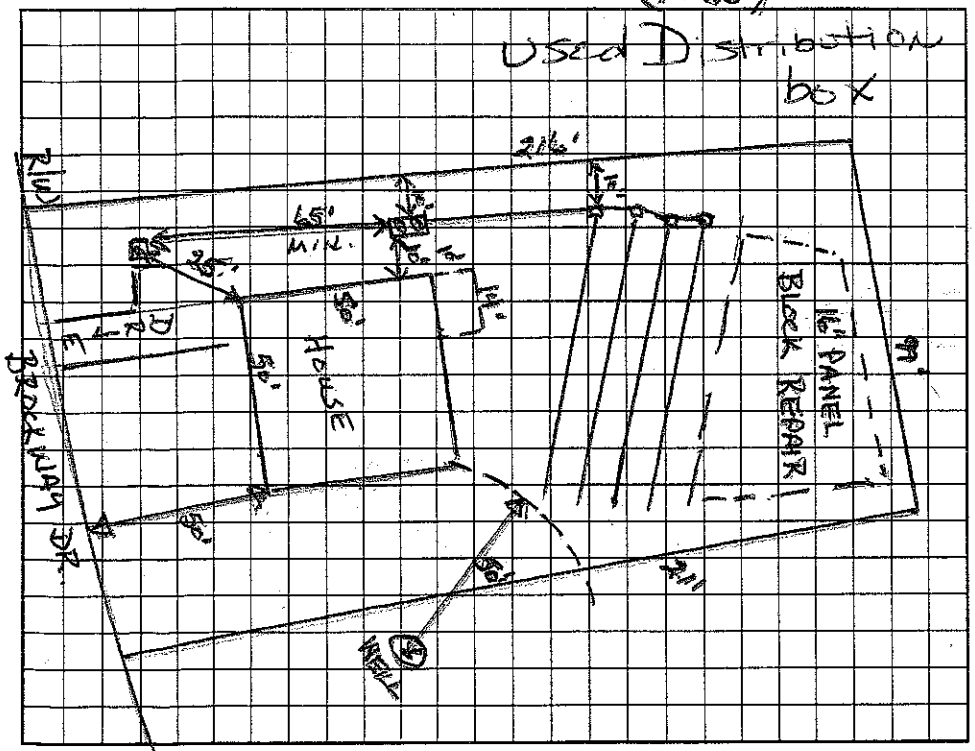

AS BUILT SKETCH

Installed Plastic Chamber

Permit can be suspended or revoked if any false information is supplied toward securing the permit/any unauthorized changes are made to the site/any unauthorized changes are made in the installation of the system. Improvement Permit with plat valid without expiration. Improvement Permit with site plan valid for sixty months. Authorization to Construct is valid for a period equal to that of Improvement Permit – not to exceed sixty months.

Signed: * J.A.M.Jell date 7/27/00 Installed by: Richard Abernathy

Improvement Permit by: Wesley Sparks RS. date 3/8/00 Operation Permit by: Mariah H. Dotson RS date 1/4/2001

Authorization to Construct by: Wesley Sparks RS. date 3/8/00 Existing System Inspection by: date

HEALTH DEPT. COPY: WHITE OWNER COPY (FINAL): YELLOW OWNER COPY (INITIAL): PINK