3:30

IRELL COUNTY HEALTH DEPARTMENT

STATESVILLE 704-878-5305 MOORESVILLE 704-664-5281

IMPROVEMENT PERMIT / AUTHORIZATION TO CONSTRUCT / OPERATION PERMIT / EXISTING SYSTEM INSPECTION

PERMIT# 82108 PIN# 4646387069 DATE 7/19/99

OWNER OR CONTRACTOR CW BREWER PHONE: Business Home

ADDRESS 260 ELYSIAN DR. MOORESVILLE NC

LOCATION WILLIAMSON RD- TR SUNDOWN - TL BROOKWAY - TR ELYSIAN - ON RT

SUBDIVISION LOCKWOOD HARBOR BLOCK / SECTION LOT 79 LOT AREA .59AC SITE CLASS PS DESIGN FLOW 360 L.T.A.R. .3

Septic Tank: 1000 Gallons; STB 1012 Date 10-29-99
Pump Tank: Gallons; PT Date
Pump Make: Model Serial No.
Nitrification Field: No Fields 1 Square Feet 700 Linear Feet 300
No Lines 5@60' Trench Width 36" Max Trench Bottom Depth 30" Gravel Depth N/A

☑ New System ☐ Repair System Type: I, II, III, IV, V, VI
System Description: GRAVITY 25% REDUCTION
Repair System Description: PANEL
Maintenance Agreement Required: ☐ Yes ☑ No

☑ House/Mod. Home No. Bedrooms 3
☐ Mobile Home No. Bathrooms 2
☐ Business No. Employees
☐ Other
☐ Slab ☑ Crawl Space ☐ Basement w/plumbing ☐ Basement wo/plumbing


Water Supply: ☑ Individual ☐ Public ☐ Community

Comments:/Conditions:


Comments:/Conditions: Riser & Filter installed

4 Chambers" installed.

INITIAL SITE SKETCH

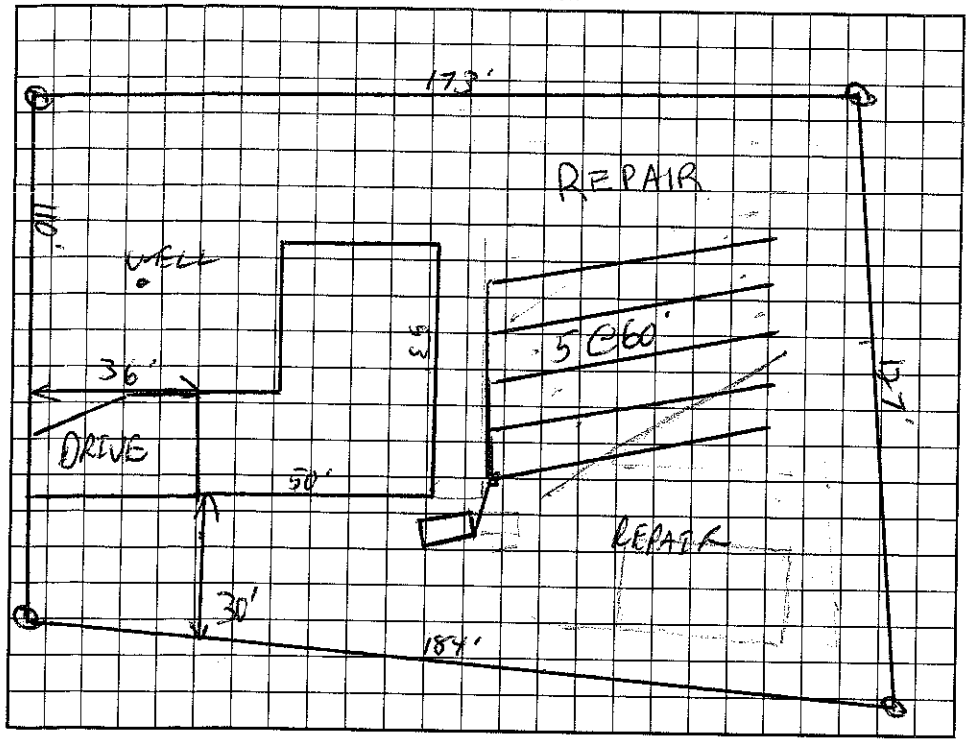

AS BUILT SKETCH

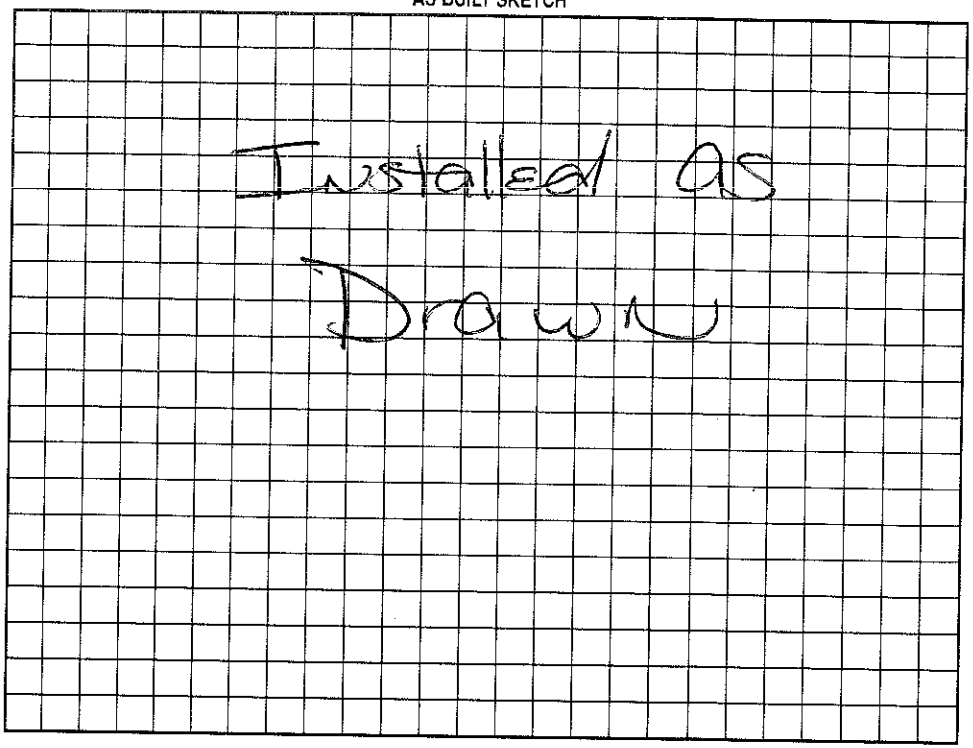

Permit can be suspended or revoked if any false information is supplied toward securing the permit/any unauthorized changes are made to the site/any unauthorized changes are made in the installation of the system. Improvement Permit with plat valid without expiration. Improvement Permit with site plan valid for sixty months. Authorization to Construct is valid for a period equal to that of Improvement Permit – not to exceed sixty months.

Signed: CW Brewer date 7/20/99

Improvement Permit by: C. [illegible] RS date 7/19/99

Authorization to Construct by: C. [illegible] RS date 7/19/99

Installed by: Richard Abernathy

Operation Permit by: [illegible] R.S. date 2/16/2000

Existing System Inspection by: date

HEALTH DEPT. COPY: WHITE OWNER COPY (FINAL): YELLOW OWNER COPY (INITIAL): PINK