IREDELL COUNTY HEALTH DEPARTMENT

STATE 704-878-5305 MOORESVILLE 704-664-5281

IMPROVEMENT PERMIT / AUTHORIZATION TO CONSTRUCT / OPERATION PERMIT / EXISTING SYSTEM INSPECTION

PERMIT# 116 244 PIN# 4646-38-7069

OWNER OR CONTRACTOR Thomas Crouse DATE 10/30/03

ADDRESS 279 Elysian Rd Mooresville NC 28117 PHONE: Business _____ Home 704-663-6019

LOCATION Williamson, TR Sundown, TL Brockway, TR Elysian on Rt

SUBDIVISION Idlewood Harbor BLOCK / SECTION _____ LOT 79 LOT AREA 0.55 AC SITE CLASS PS DESIGN FLOW 360 L.T.A.R. _____

Septic Tank: Existing Gallons: STB _____ Date _____

Pump Tank: _____ Gallons: PT _____ Date _____

Pump Make: _____ Model _____ Serial No. _____

Nitrification Field: No Fields ____ Square Feet 900 Linear Feet 300' Ex.

No Lines 5 Trench Width — Max Trench Bottom Depth — Gravel Depth —

☐ New System ☐ Repair System Type: I, II, III, IV, V, VI

System Description: Ex. 25% Reduction

Repair System Description: Limited - Deed Prior to

Maintenance Agreement Required: ☐ Yes ☒ No 1983

☒ House/Mod. Home No. Bedrooms 3½

☐ Mobile Home No. Bathrooms ____

☐ Business No. Employees ____

☐ Other _____

☐ Slab ☒ Crawl Space ☐ Basement w/plumbing ☐ Basement wo/plumbing


Water Supply: ☒ Individual ☐ Public ☐ Community

Comments:/Conditions:


Comments:/Conditions:

Original Permit - C.W. Brewer 2000

INITIAL SITE SKETCH

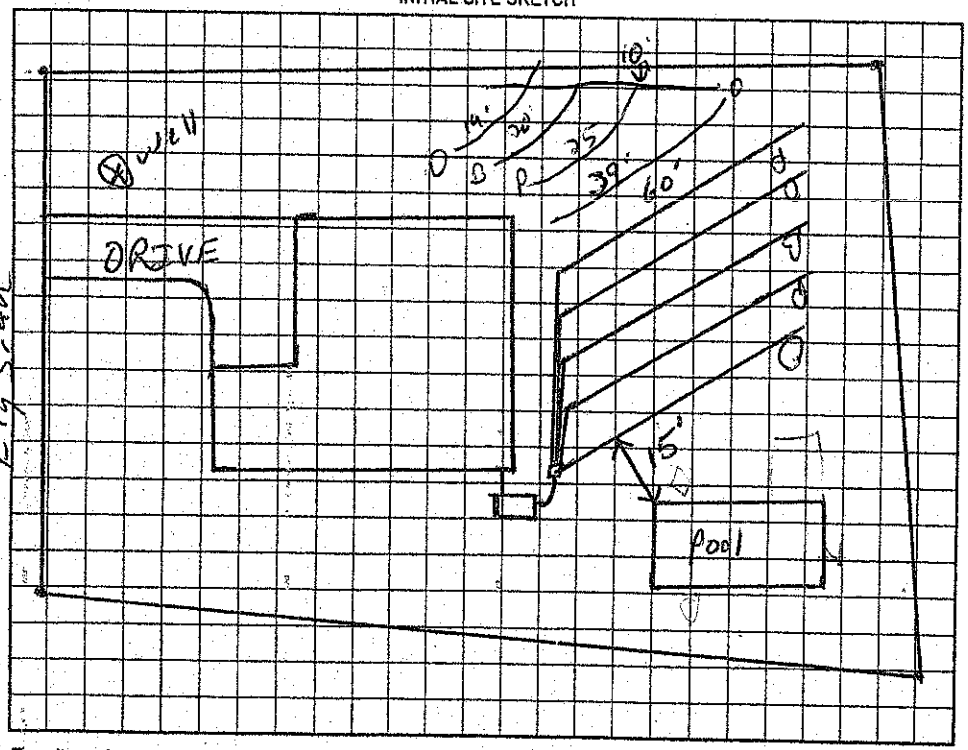

AS BUILT SKETCH

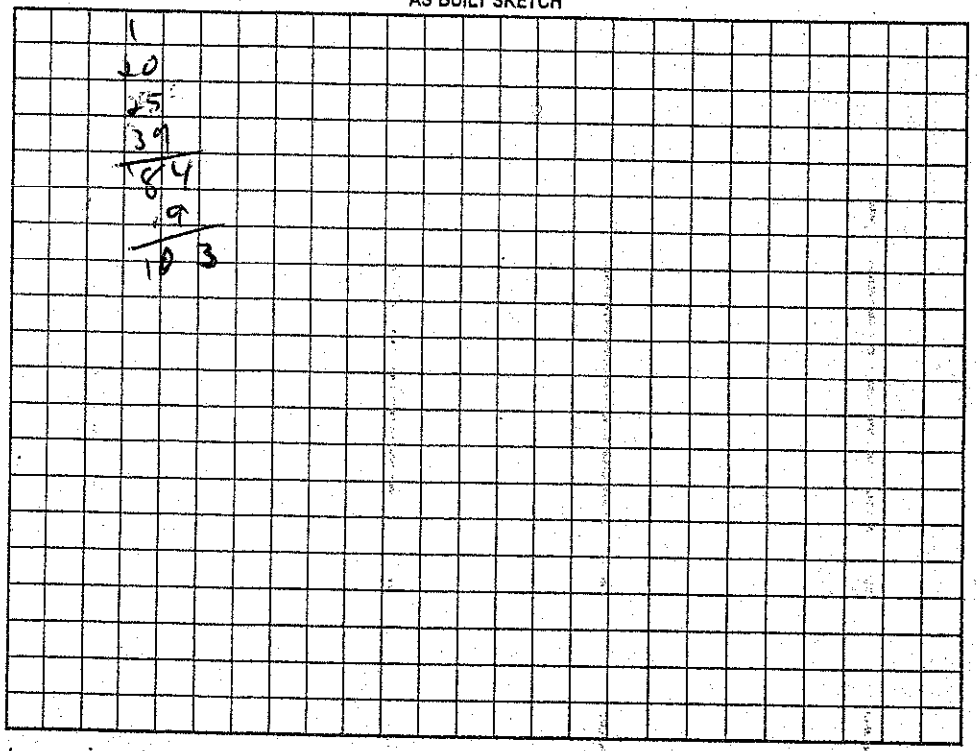

Permit can be suspended or revoked if any false information is supplied toward securing the permit/any unauthorized changes are made to the site/any unauthorized changes are made in the installation of the system. Improvement Permit with plat valid without expiration. Improvement Permit with site plan valid for sixty months. Authorization to Construct is valid for a period equal to that of Improvement Permit – not to exceed sixty months.

Signed: _____ date _____ Installed by: _____

Improvement Permit by: _____ date _____ Operation Permit by: _____ date _____

Authorization to Construct by: _____ date _____ Existing System Inspection by: RS date 10/30/03

HEALTH DEPT. COPY: WHITE OWNER COPY (FINAL): YELLOW OWNER COPY (INITIAL): PINK