IREDELL COUNTY HEALTH DEPARTMENT

STATESVILLE 704-878-5305 MOORESVILLE 704-664-5281

IMPROVEMENT PERMIT / AUTHORIZATION TO CONSTRUCT / OPERATION PERMIT / EXISTING SYSTEM INSPECTION

PERMIT# 105989 PIN# ~~4646 20 4611.54~~ 4646-39-0006 DATE 8/16/02

OWNER OR CONTRACTOR DIENST ENTERPRISES/ Ryan Homes PHONE: Business 309-0123 Home

ADDRESS 19315 W. CATAWBA AVE SUITE 290 CORNELIUS NC 28031

LOCATION WILLIAMSON - JR SUNDOWN - JR ECLIPSE - TL CORONA - ON LT

SUBDIVISION ESTATES @ SUNDOWN BLOCK / SECTION 1 LOT 54 LOT AREA 25000 ft² SITE CLASS. PS DESIGN FLOW 360 GPD L.T.A.R. .2 GPD/FT²

Septic Tank: 1000 Gallons; STB 794 Date 4-12-05
Pump Tank: 1000 Gallons; PT 283 Date 6-14-05
Pump Make: Gaids Model LVE0312M5 Serial No.
Nitrification Field: No Fields 1 Square Feet 600 Linear Feet 300
No Lines 5@60' Trench Width 24" Max Trench Bottom Depth 36" Gravel Depth N/A

☑ New System ☐ Repair System Type: I, II, III, IV, V, VI
System Description: LP PANEL
Repair System Description: SAME
Maintenance Agreement Required: ☑ Yes ☐ No


☑ House/Mod. Home No. Bedrooms 3
☐ Mobile Home No. Bathrooms 3
☐ Business No. Employees
☐ Other
☐ Slab ☑ Crawl Space ☐ Basement w/plumbing ☐ Basement wo/plumbing

Water Supply: ☐ Individual ☐ Public ☑ Community

Comments:/Conditions: 1) 4 BEDROOM HOUSE WILL NOT FIT. 2) INLINE PUMP FILTER TO BE INSTALLED

Comments:/Conditions: Checked lower 3 lines 7/19/05
Checked other 2 lines 7/20/05
Tanks Checked 7/19/05
Soil real hard to dig; very hard

INITIAL SITE SKETCH 1"=50'

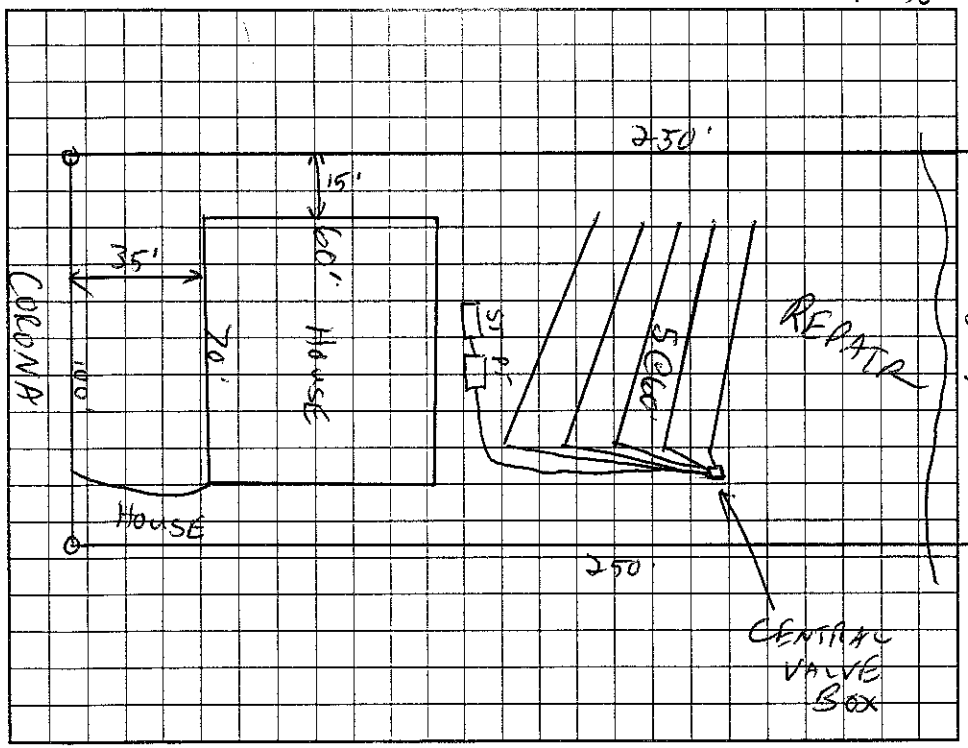

AS BUILT SKETCH

Pressure, effl & alarm 8/1/05
Installed essentially as Drawn

Permit can be suspended or revoked if any false information is supplied toward securing the permit/any unauthorized changes are made to the site/any unauthorized changes are made in the installation of the system. Improvement Permit with plat valid without expiration; Improvement Permit with site plan valid for sixty months. Authorization to Construct is valid for a period equal to that of Improvement Permit – not to exceed sixty months.

Signed: Robert B. Friend date 9/20/02 Installed by: R & H Maint. H. Dotson RS date 8/1/05

Improvement Permit by: C. [illegible] RS date 8/16/02 Operation Permit by: date

Authorization to Construct by: [illegible] RS date 4/15/05 Existing System Inspection by: date

HEALTH DEPT. COPY: WHITE OWNER COPY (FINAL): YELLOW OWNER COPY (INITIAL): PINK