IREDELL COUNTY HEALTH DEPARTMENT

STATESVILLE 704-878-5305 MOORESVILLE 704-664-5281

IMPROVEMENT PERMIT / AUTHORIZATION TO CONSTRUCT / OPERATION PERMIT / EXISTING SYSTEM INSPECT.

PERMIT# 105 988 PIN# ~~4646 20 76 11.53~~ 4646-39-0115 DATE 8/16/02

OWNER OR CONTRACTOR DIENST ENTERPRISES PHONE: Business 309-0143 Home

ADDRESS 19315 W. CATAWBA AVE. SUITE 200 CORNELIUS NC 28031

LOCATION WILLIAMSON - TR SUNDOWN - TR ECLIPSE - TL CORONA - ON LT

SUBDIVISION ESTATES @ SUNDOWN BLOCK / SECTION 1 LOT 53 LOT AREA 25,000 ft² SITE CLASS. RS DESIGN FLOW 480GAD L.T.A.R. .2 ~~.1~~

Septic Tank: 1000 Gallons; STB 312 Date 5-11-06
Pump Tank: 1000 Gallons; PT 2 Date 5-21-06
Pump Make: Goulds Model WE0312M Serial No.
Nitrification Field: No Fields 1 Square Feet 800 Linear Feet 400
No Lines 5@80' Trench Width 24" Max Trench Bottom Depth 36" Gravel Depth N/A

☑ New System ☐ Repair System Type: I, II, III, IV, V, VI
System Description: LP PANEL
Repair System Description: SAME
Maintenance Agreement Required: ☑ Yes ☐ No

☑ House/Mod. Home No. Bedrooms 4
☐ Mobile Home No. Bathrooms 4
☐ Business No. Employees
☐ Other


☐ Slab ☑ Crawl Space ☐ Basement w/plumbing ☐ Basement wo/plumbing

Water Supply: ☐ Individual ☐ Public ☑ Community

Comments/Conditions: 1) INLINE PUMP FILTER TO BE INSTALLED


Comments:/Conditions: Pres, elect & alarm 7/13/06 MO

INITIAL SITE SKETCH 1"=50'

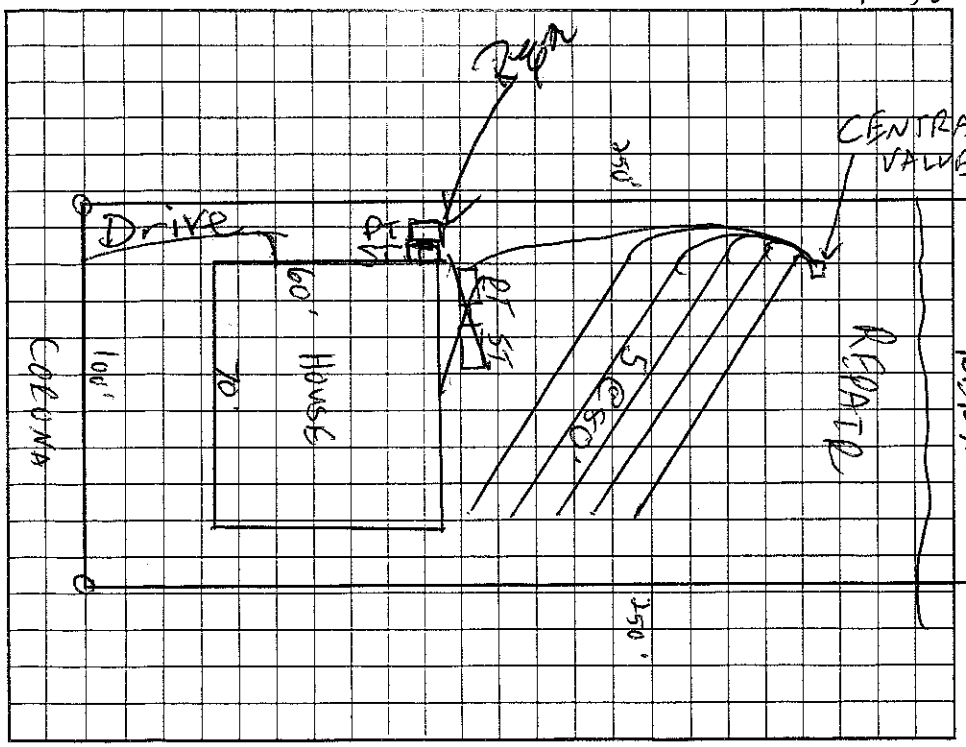

AS BUILT SKETCH

6/22/06 Installed essentially as Drawn
Tanks moved to Side of house.

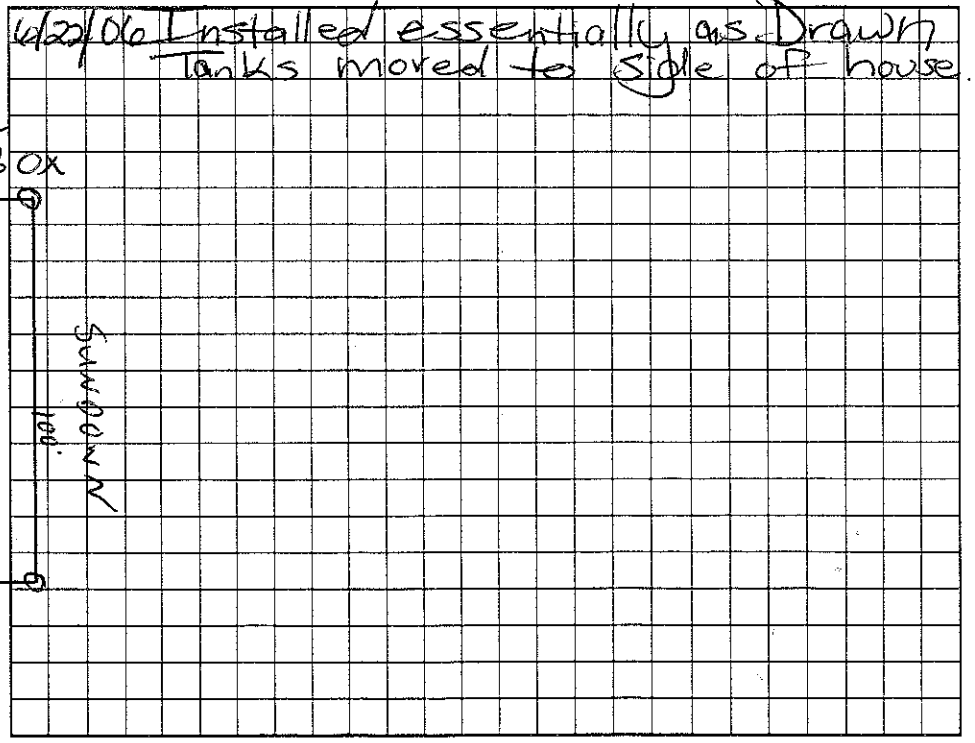

Permit can be suspended or revoked if any false information is supplied toward securing the permit/any unauthorized changes are made to the site/any unauthorized changes are made in the installation of the system. Improvement Permit with plat valid without expiration. Improvement Permit with site plan valid for sixty months. Authorization to Construct is valid for a period equal to that of Improvement Permit – not to exceed sixty months.

Signed: Robert B. Dienst date 9/20/02

Improvement Permit by: RS date 8/16/02

Authorization to Construct by: RS date 2/14/06

Installed by: R & H

Operation Permit by: Mona Hill Dotson RS date 7/13/06

Existing System Inspection by: date

HEALTH DEPT. COPY: WHITE OWNER COPY (FINAL): YELLOW OWNER COPY (INITIAL): PINK