IREDELL COUNTY HEALTH DEPARTMENT

STATESVILLE 704-878-5305 MOORESVILLE 704-664-5281

IMPROVEMENT PERMIT / AUTHORIZATION TO CONSTRUCT / OPERATION PERMIT / EXISTING SYSTEM INSPECTION

DATE 8/16/02

PERMIT# 105985 PIN# ~~4646-20-46-44-50~~ 4646390415

OWNER OR CONTRACTOR OLENSI ~~ENTERPRISES~~ ENTERPRISES/Ryan PHONE: Business 309-0123 Home

ADDRESS 19315 CATAWBA AVENUE - SUITE 200 CORNELIUS NC 28031

LOCATION WILLIAMSON - TR SUNDOWN - TL ECLIPSE - ON LT CORNER

SUBDIVISION ESTATES @ SUNDOWN BLOCK / SECTION 3 LOT 50 LOT AREA 25852 ft² SITE CLASS. PS DESIGN FLOW 480GPD L.T.A.R. .25 gpd/Lft²

Septic Tank: 1000 Gallons; STB 312 Date 4-30-05

Pump Tank: 1000 Gallons; PT 27 Date 5-9-05

Pump Make: ____ Model ____ Serial No. ____

Nitrification Field: No Fields 1 Square Feet 640 Linear Feet 320

No Lines 4 @ 80' Trench Width 24" Max Trench Bottom Depth 36" Gravel Depth N/A

☑ New System ☐ Repair System Type: I. II. III. (IV) V. VI

System Description: LP PANEL

Repair System Description: SAME

Maintenance Agreement Required: ☑ Yes ☐ No

☑ House/Mod. Home No. Bedrooms 4

☐ Mobile Home No. Bathrooms 4

☐ Business No. Employees ____

☐ Other ____


☐ Slab ☑ Crawl Space ☐ Basement w/plumbing ☐ Basement wo/plumbing

Water Supply: ☐ Individual ☐ Public ☐ Community


Comments/Conditions: 1) INLINE PUMP FILTER TO BE INSTALLED

Comments/Conditions: 3/16" hole drilled
Checked tanks 6/14/05 & Checked lines 6/15/05 Pressure, Cleat & alarm 7/14/05

INITIAL SITE SKETCH 1"=50'

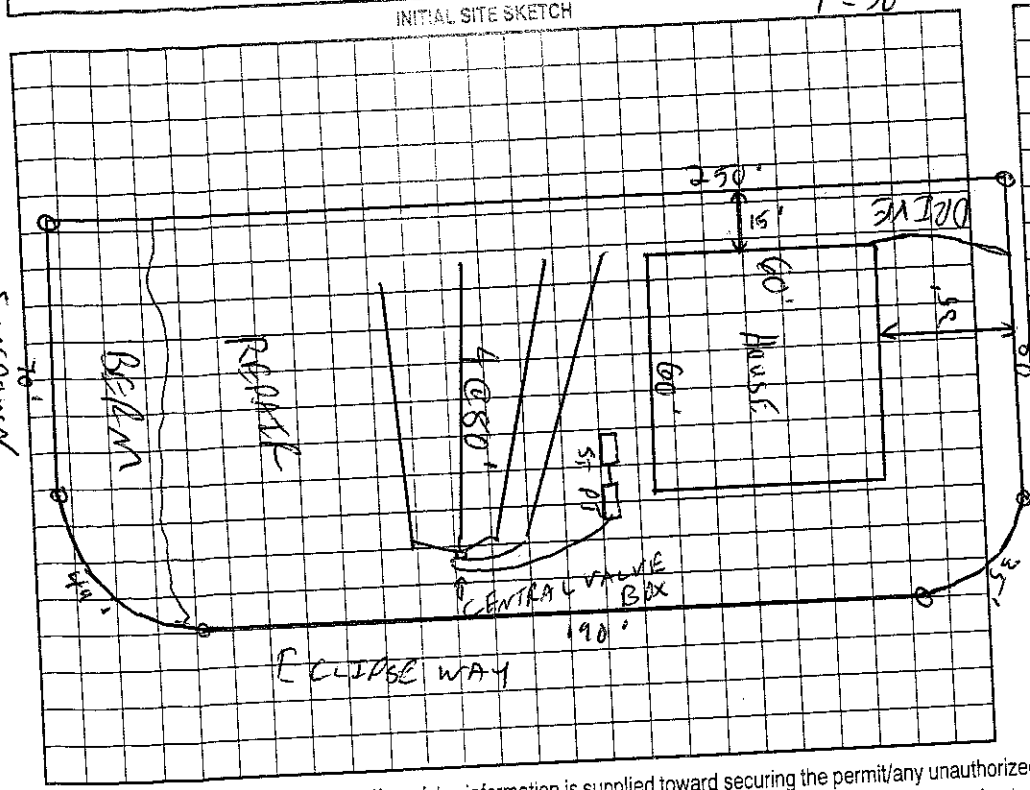

AS BUILT SKETCH

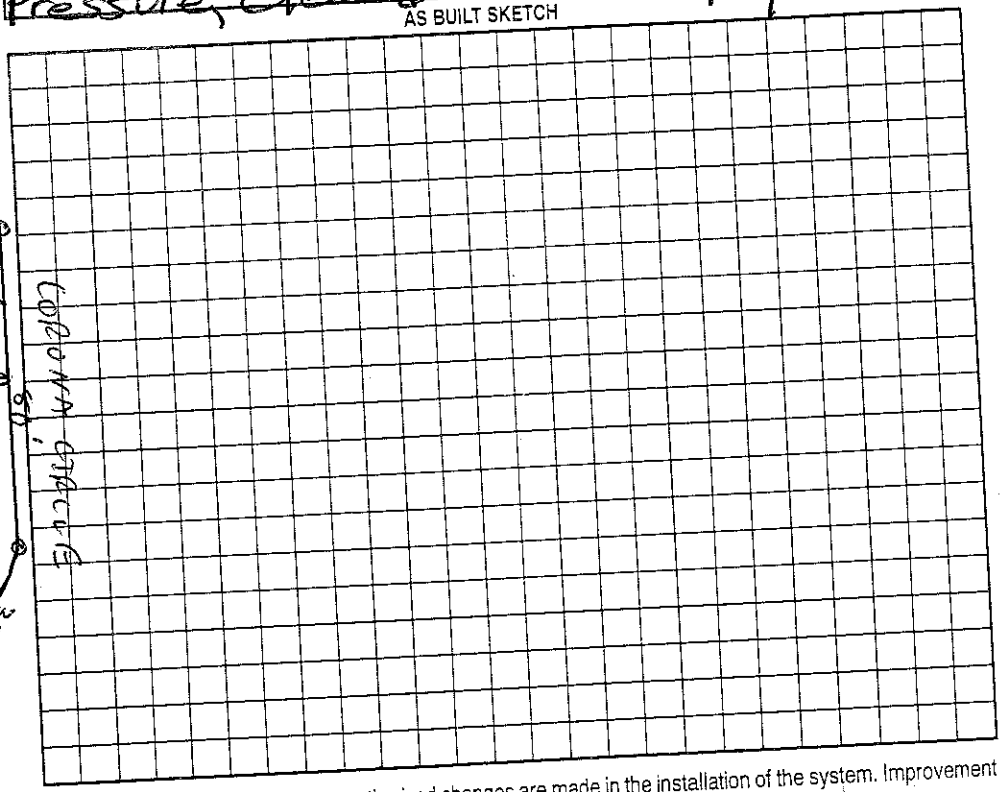

Permit can be suspended or revoked if any false information is supplied toward securing the permit/any unauthorized changes are made to the site/any unauthorized changes are made in the installation of the system. Improvement Permit with plat valid without expiration. Improvement Permit with site plan valid for sixty months. Authorization to Construct is valid for a period equal to that of Improvement Permit – not to exceed sixty months.

Signed: Robert B. Drenst RS date 9/20/02

Improvement Permit by: C. [illegible] date 8/16/02

Installed by: R & T Dobson PS date 7/14/05

Operation Permit by: [illegible] date 4/15/05

Existing System Inspection by: ____ date ____

OWNER COPY (FINAL): YELLOW OWNER COPY (INITIAL): PINK