IREDELL COUNTY HEALTH DEPARTMENT

STATESVILLE 704-878-5305 MOORESVILLE 704-664-5281

375.00 Paid 4646 39 3835

IMPROVEMENT PERMIT / AUTHORIZATION TO CONSTRUCT / OPERATION PERMIT / EXISTING SYSTEM INSPECTION

PERMIT# 095521 PIN# 4646 39 3835 DATE 5/3/01

OWNER OR CONTRACTOR TOM PURCELL (KEVIN RIEBELING) PHONE: Business Home 598-3800

ADDRESS 5009 N. RIDGE BUS CNTR Cadwallader, NC. 28249 141 SUNDOWN RD.

LOCATION Williamson Rd S TR Sundown Rd. 1st 2nd lot on L

SUBDIVISION IDELWOOD HAR. BLOCK / SECTION 3 LOT 40 LOT AREA .9AC SITE CLASS. PS (FRONT) DESIGN FLOW 360 L.T.A.R. .25

Septic Tank: 1000 Gallons; STB 794 Date 9/9/01

Pump Tank: 1000 Gallons; PT 21 Date 9/25/01

Pump Make: MYERS Model ME50-51 Serial No. 4-01

Nitrification Field: No Fields 1 Square Feet 480 Linear Feet 240

No Lines 3@80' Trench Width 2'0"3' Max Trench Bottom Depth 36"

[X] New System [ ] Repair System Type: I, II, III, (IV), V, VI

System Description: PRESSURIZED 16" PBPS

Repair System Description: SAME

Maintenance Agreement Required: [X] Yes [ ] No

Gravel Depth No

[X] House/Mod. Home No. Bedrooms 3

[ ] Mobile Home No. Bathrooms 3

[ ] Business No. Employees

[ ] Other


[ ] Slab [ ] Crawl Space [X] Basement w/plumbing [ ] Basement wo/plumbing

Water Supply: [X] Individual [ ] Public [ ] Community


Comments/Conditions: Pump must deliver 336 GPM minimum against appropriate Elevation and Pressure Head
Maintenance Contract Required - 3/16" holes

Comments/Conditions: 283402

INITIAL SITE SKETCH (1" = 50')

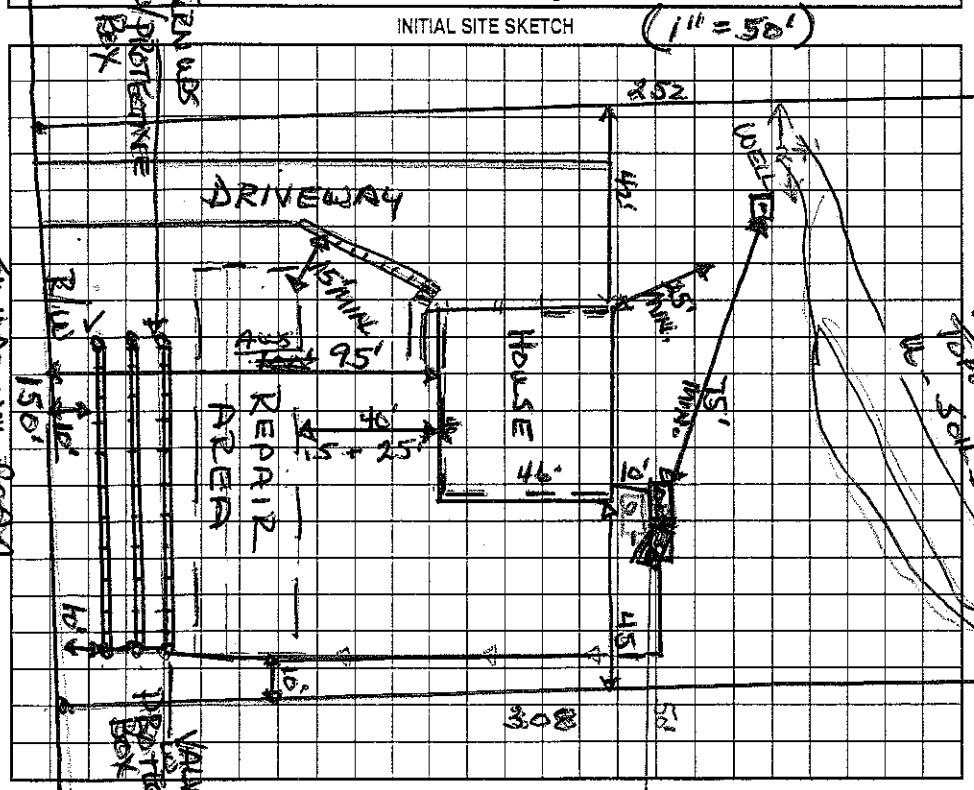

AS BUILT SKETCH

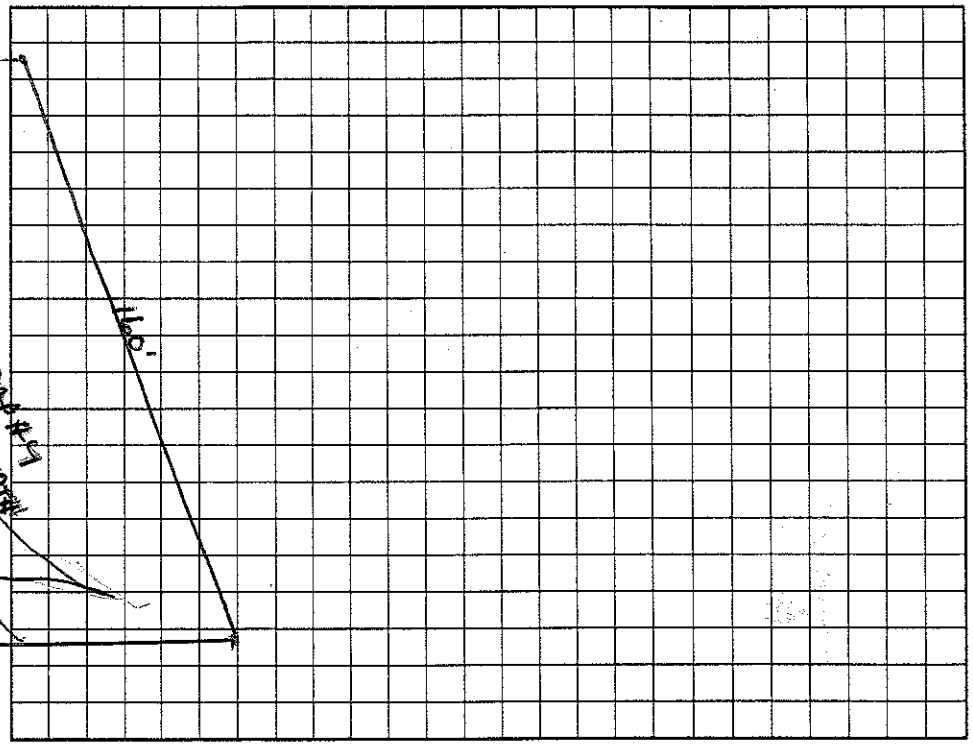

Permit can be suspended or revoked if any false information is supplied toward securing the permit/any unauthorized changes are made to the site/any unauthorized changes are made in the installation of the system. Improvement Permit with plat valid without expiration. Improvement Permit with site plan valid for sixty months. Authorization to Construct is valid for a period equal to that of Improvement Permit – not to exceed sixty months.

Signed: [signature] date 5/9/01 Installed by: Larry Tucker Jr.

Improvement Permit by: Wesley Sparks RS. date 5/3/01 Operation Permit by: Wesley Sparks RS. date 2/27/02

Authorization to Construct by: Wesley Sparks RS date 5/3/01 Existing System Inspection by: date

HEALTH DEPT. COPY: WHITE OWNER COPY (FINAL): YELLOW OWNER COPY (INITIAL): PINK