IREDELL COUNTY HEALTH DEPARTMENT

STATESVILLE 704-878-5305 130.00 Paid MOORESVILLE 704-664-5281 3:00

IMPROVEMENT PERMIT / AUTHORIZATION TO CONSTRUCT / OPERATION PERMIT / EXISTING SYSTEM INSPECTI

PERMIT# 111704 PIN# 4646395184 4646-39-4154 DATE 5-19-03

OWNER OR CONTRACTOR Kenneth Taffaro Mathews Building Corp PHONE: Business 202-7071 Home 642-0403

ADDRESS 2229 Pimm Rd Charlotte NC 28117

LOCATION Williamson Rd TL Sundown TL Brock Way TL Elysian at end

SUBDIVISION Idlewood Harbor BLOCK / SECTION ____ LOT 60 LOT AREA .87 Acre SITE CLASS. PS DESIGN FLOW 360gpd L.T.A.R. .25-.3

Septic Tank: 1000 Gallons; STB 794 Date 5-3-05
Pump Tank: 1000 Gallons; PT ____ Date ____
Pump Make: ____ Model 1080 Serial No. 3600
Nitrification Field: No Fields 1 Square Feet ~~1440~~ Linear Feet ~~480~~
No Lines 3@120' Trench Width 36" Max Trench Bottom Depth 36" Gravel Depth N/A

☒ New System ☐ Repair System Type: I, II, (III), IV, V, VI
System Description: Pump-Pm-25% reduction
Repair System Description: pump-Innovative
Maintenance Agreement Required: ☐ Yes ☒ No

☒ House/Mod. Home No. Bedrooms 4
☐ Mobile Home No. Bathrooms 2.5
☐ Business No. Employees ____
☐ Other ____

☐ Slab ☒ Crawl Space ☐ Basement w/plumbing ☐ Basement wo/plumbing


Water Supply: ☒ Individual ☐ Public ☐ Community

Comments/Conditions: Keep Septic system at least 10' from PL & 50'-100' to any well. Keep well at least 25' from House & at least 50' from any Septic System

Comments/Conditions: 7/05 Reviewed Building plans, essentially in Compliance with original permit.
4@90'

INITIAL SITE SKETCH

Scale 1:60'

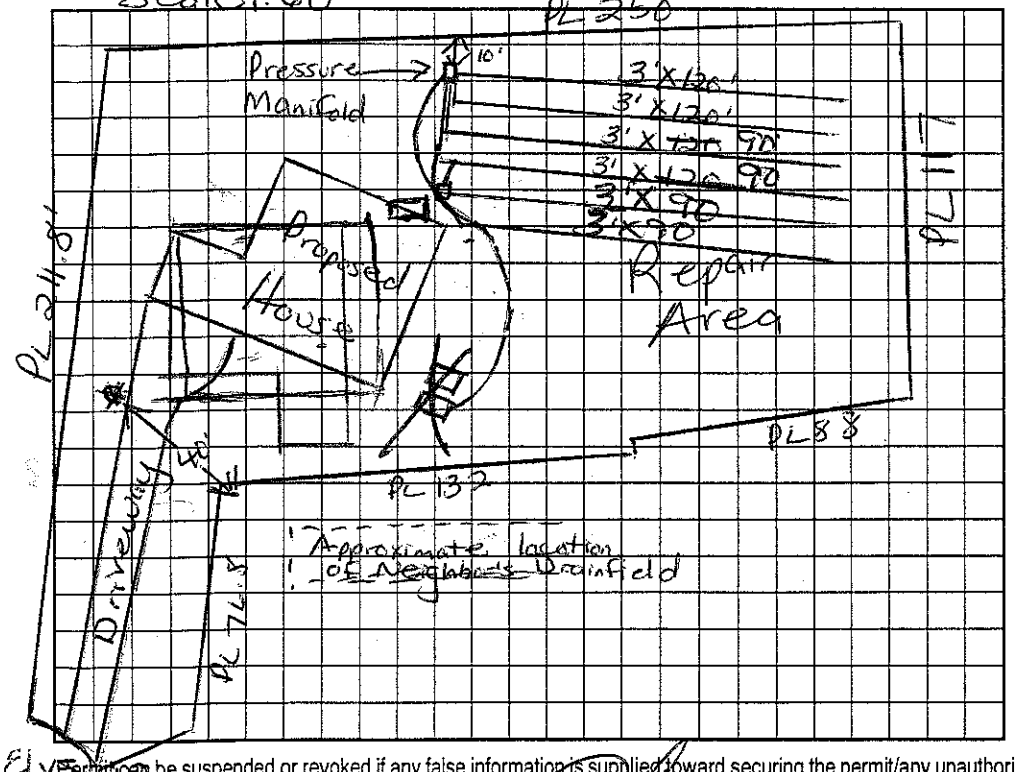

AS BUILT SKETCH

Note. House moved farther forward ST behind house & gravity flow to Drainfield. Drainlines EZ Flow 35-50-~~60~~ ft off back line.

As Built attached

Elysian Rd.

Permit can be suspended or revoked if any false information is supplied toward securing the permit/any unauthorized changes are made to the site/any unauthorized changes are made in the installation of the system. Improvement Permit with plat valid without expiration. Improvement Permit with site plan valid for sixty months. Authorization to Construct is valid for ~~a period equal~~ to that of Improvement Permit – not to exceed sixty months.

Signed: [signature] date 5-20-03 Installed by: TW Ammons

Improvement Permit by: Maria H. Dolan RS date 5/9/03 Operation Permit by: Maria H. Dolan RS date 6/29/05

Authorization to Construct by: Maria H. Dolan RS date 11/7/05 Existing System Inspection by: ____ date ____

HEALTH DEPT. COPY: WHITE OWNER COPY (FINAL): YELLOW OWNER COPY (INITIAL): PINK

IREDELL COUNTY HEALTH DEPARTMENT

STATESVILLE 704-878-5305 MOORESVILLE 704-664-5281

IMPROVEMENT PERMIT / AUTHORIZATION TO CONSTRUCT / OPERATION PERMIT / EXISTING SYSTEM INSPECTION

PERMIT# 111704 PIN# 4646 395 184 DATE 6/29/05

OWNER OR APPLICANT Matthews Building Corp PHONE: Business _____ Home _____

ADDRESS _____

LOCATION _____

SUBDIVISION Idlewood Harbor BLOCK / SECTION _____ LOT 60 LOT AREA .87 Acre SITE CLASS. PS DESIGN FLOW 360gpd L.T.A.R. .25-.3

Septic Tank: 1000 Gallons: ST8 794 Date 5-3-05
Pump Tank: ~~1000~~ Gallons: PT _____ Date _____
Pump Make: _____ Model _____ Serial No. _____
Nitrification Field: No Fields 1 Square Feet 1080 Linear Feet 360
No Lines 4@90' Trench Width 36" Max Trench Bottom Depth 36"

☒ New System ☐ Repair ☐ Expansion System Type: I II III IV V VI
System Description: _____
Repair System Description: _____
Maintenance Agreement Required: ☐ Yes ☐ No

☒ House/Mod. Home No. Bedrooms 3
☐ Mobile Home No. Persons 25
☐ Business No. Employees ____
☐ Other _____

Water Supply: ☒ Individual ☐ Public ☐ Community


Gravel Depth N/A ☐ Gravity ☐ Pressure ☐ Slab ☐ Crawl Space ☐ Basement w/plumbing ☐ Basement wo/plumbing

Comments:/Conditions:

INITIAL SITE SKETCH Scale 1:60

Comments:/Conditions:

AS BUILT SKETCH

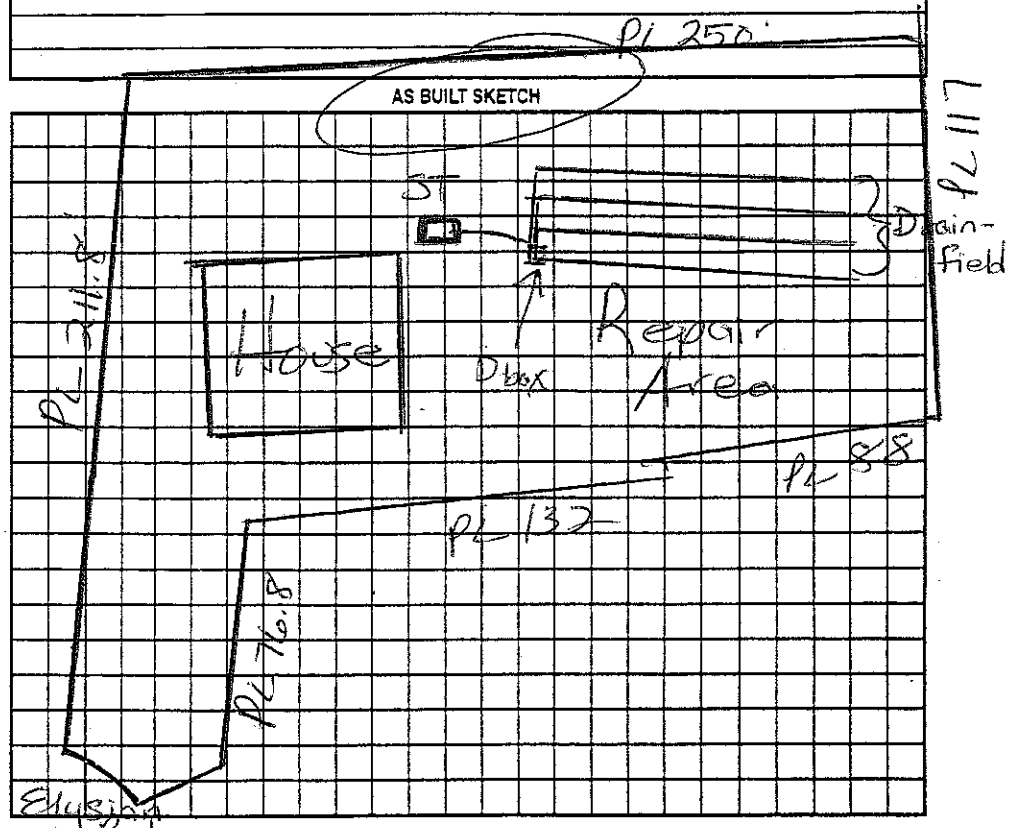

Permit can be suspended or revoked if any false information is supplied toward securing the permit/any unauthorized changes are made to the site/any unauthorized changes are made in the installation of the system. Improvement Permit with plat valid without expiration ☐ Improvement Permit with site plan valid for sixty months ☐ Authorization to Construct is valid for a period equal to that of Improvement Permit – not to exceed sixty months.

Signed: _____ date _____

Improvement Permit by: _____ date _____

Authorization to Construct by: _____ date _____

Installed by: TW Ammons

Operation Permit by: [signature] RS date 6/29/05

Existing System Inspection by: _____ date _____

HEALTH DEPT. COPY: WHITE OWNER COPY (FINAL): YELLOW OWNER COPY (INITIAL): PINK