IREDELL COUNTY HEALTH DEPARTMENT

STATESVILLE 704-878-5305 MOORESVILLE 704-664-5281

Paid 125.00 100

IMPROVEMENT PERMIT / AUTHORIZATION TO CONSTRUCT / OPERATION PERMIT / EXISTING SYSTEM INSPECTION

PERMIT# 225 Mesvl. 135386 PIN# 4645-59-2250 4646407065 DATE Dec 19,01

OWNER OR CONTRACTOR Dienst Enterprises Inc. / Pride Homes PHONE: Business _____ Home _____

ADDRESS 125 Easton Dr. Mooresville NC 28117

LOCATION _____

SUBDIVISION Templeton Bay BLOCK / SECTION _____ LOT 39/39A LOT AREA 28440 + 14400 ft² SITE CLASS. PS SFE DESIGN FLOW 480gpd L.T.A.R. .025-.3 SFE 39A

Septic Tank: 1000 Gallons; STB 1012 Date 7-24-06
Pump Tank: 1000 Gallons; PT 1014 Date 4-22-06
Pump Make: Gould's Model WE2012 Serial No. _____
Nitrification Field: No Fields 1 Square Feet 1350 Linear Feet 450
No Lines 5@90' Trench Width 36" Max Trench Bottom Depth 36" Gravel Depth N/A

☑ New System ☐ Repair System Type: I, II, III, IV, V, VI
System Description: PM - Innovative - 25% Red.
Repair System Description: Same
Maintenance Agreement Required: ☐ Yes ☑ No


☑ House/Mod. Home No. Bedrooms 4
☐ Mobile Home No. Bathrooms 4
☐ Business No. Employees _____
☐ Other _____
☐ Slab ☐ Crawl Space ☑ Basement w/plumbing ☐ Basement wo/plumbing

Water Supply:
☐ Individual
~~☑ Public~~
~~☑ Community~~

Comments:/Conditions:
Remove any old burms in septic fall/easement.

Comments:/Conditions:

INITIAL SITE SKETCH

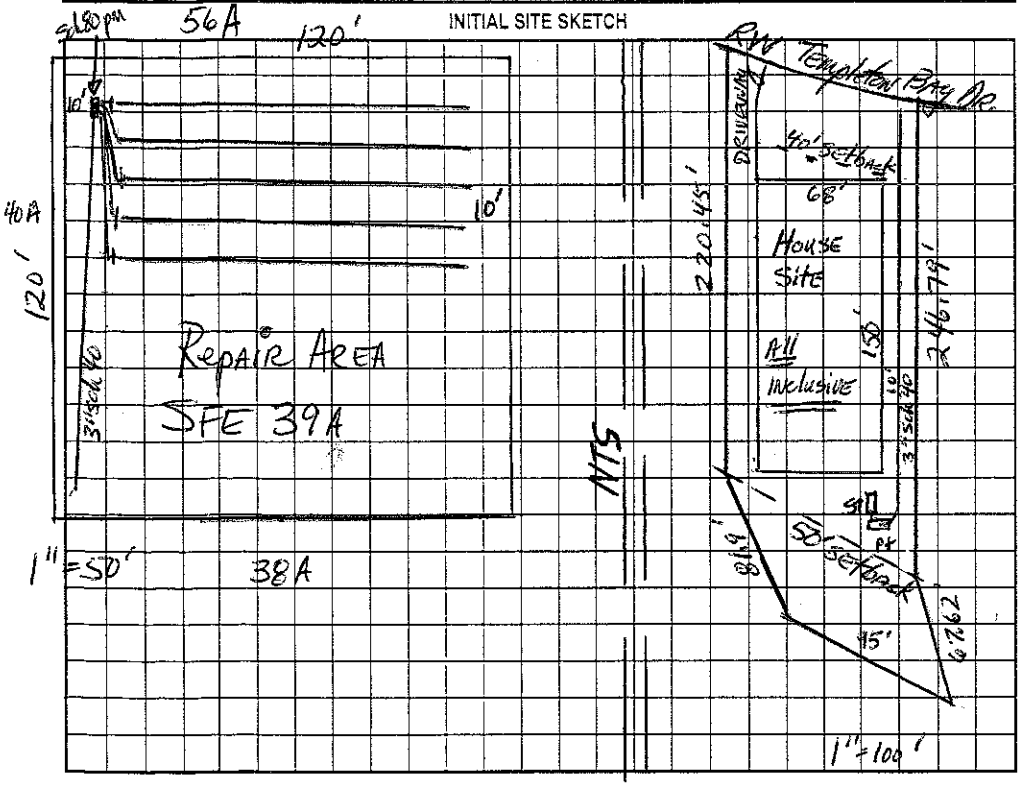

AS BUILT SKETCH

The proposed / existing Pool addition does not appear to impact the existing septic system.
**NOTE: Permit originally drawn for Pool

R.S.
Date: 7-9-09
ICHD-Environmental Health Division

Permit can be suspended or revoked if any false information is supplied toward securing the permit/any unauthorized changes are made to the site/any unauthorized changes are made in the installation of the system. Improvement Permit valid without expiration. Improvement Permit with site plan valid for sixty months. Authorization to Construct is valid for a period equal to that of Improvement Permit – not to exceed sixty months.

_____ date 1/29/02
_____ date 12-19-01 Update

Installed by: C & S
Operation Permit by: John E. Alt date 3/16/09
Existing System Inspection by: _____ date _____

YELLOW OWNER COPY (INITIAL): PINK