#1136401

IREDELL COUNTY HEALTH DEPARTMENT

STATESVILLE 704-878-5305 125.00 Paid MOORESVILLE 704-664-5281 2105

IMPROVEMENT PERMIT / AUTHORIZATION TO CONSTRUCT / OPERATION PERMIT / EXISTING SYSTEM INSPECTION

PERMIT# 225 MRSW. PIN# ~~4645-59-2250~~ 4646407378.000 DATE Dec. 20, 01

OWNER OR CONTRACTOR Diehl Enterprises Inc. / Unlimited Construction PHONE: Business _____ Home _____

ADDRESS 125 Easton Dr. Mooresville NC 28117 #205

LOCATION 215. TL Alcove TR Templeton TR Templeton Bay on left NEAR/AT END

SUBDIVISION Templeton Bay BLOCK / SECTION _____ LOT 41/41A LOT AREA 33279+ 17387+ ft² SITE CLASS. PS SFE DESIGN FLOW 480 gpd L.T.A.R. .03 SFE 41A

Septic Tank: 1000 Gallons; STB 794 Date 10-16-03
Pump Tank: 1000 Gallons; PT 27 Date 12-30-03
Pump Make: Meyers Model P102 Serial No. _____
Nitrification Field: No Fields 1 Square Feet 1200 Linear Feet 400
No Lines 4@100' Trench Width 36" Max Trench Bottom Depth 36" Gravel Depth NA

☑ New System ☐ Repair System Type: I, II, III, IV, V, VI
System Description: PM- Innovative -25% Red.
Repair System Description: same
Maintenance Agreement Required: ☐ Yes ☑ No

☑ House/Mod. Home No. Bedrooms 4
☐ Mobile Home No. Bathrooms 4
☐ Business No. Employees _____
☐ Other _____
☐ Slab ☐ Crawl Space ☑ Basement w/plumbing ☐ Basement wo/plumbing


Water Supply: ☐ Individual ☐ Public ☐ Community

Comments:/Conditions:
Remove any old burns in septic field easement.


Comments:/Conditions: No plumbing in basement Therefore tanks in front
Tanks checked 2/4/04 Lines & pressure checked
Elect & alarm 2/20/04

1"=50'

INITIAL SITE SKETCH

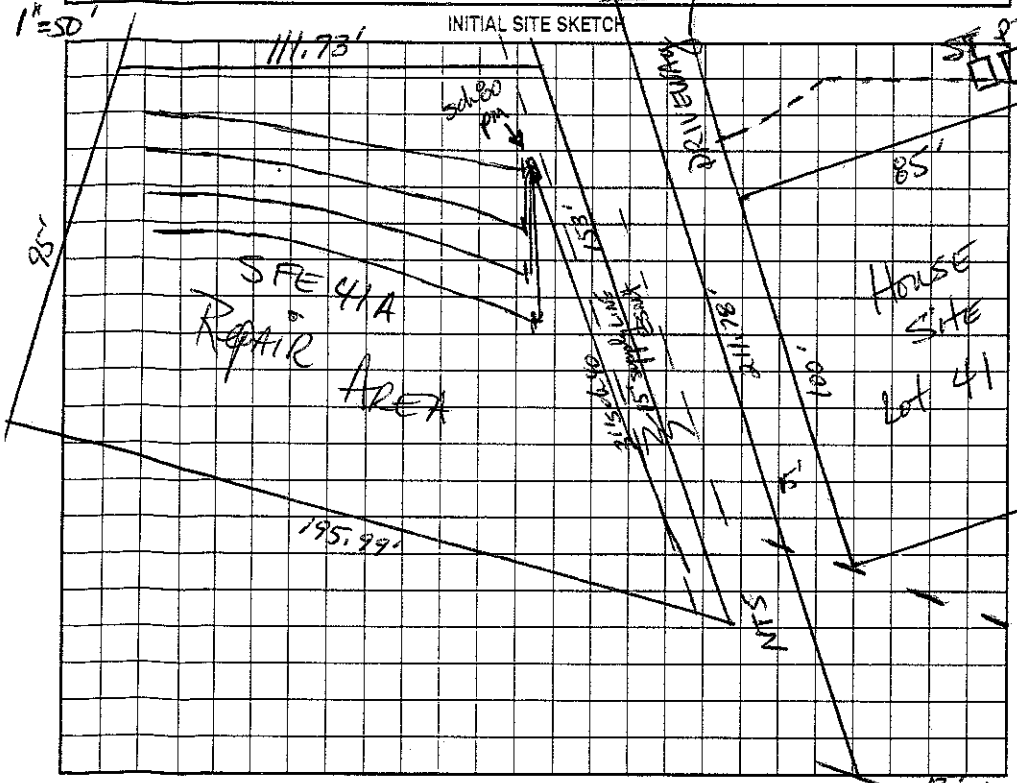

AS BUILT SKETCH

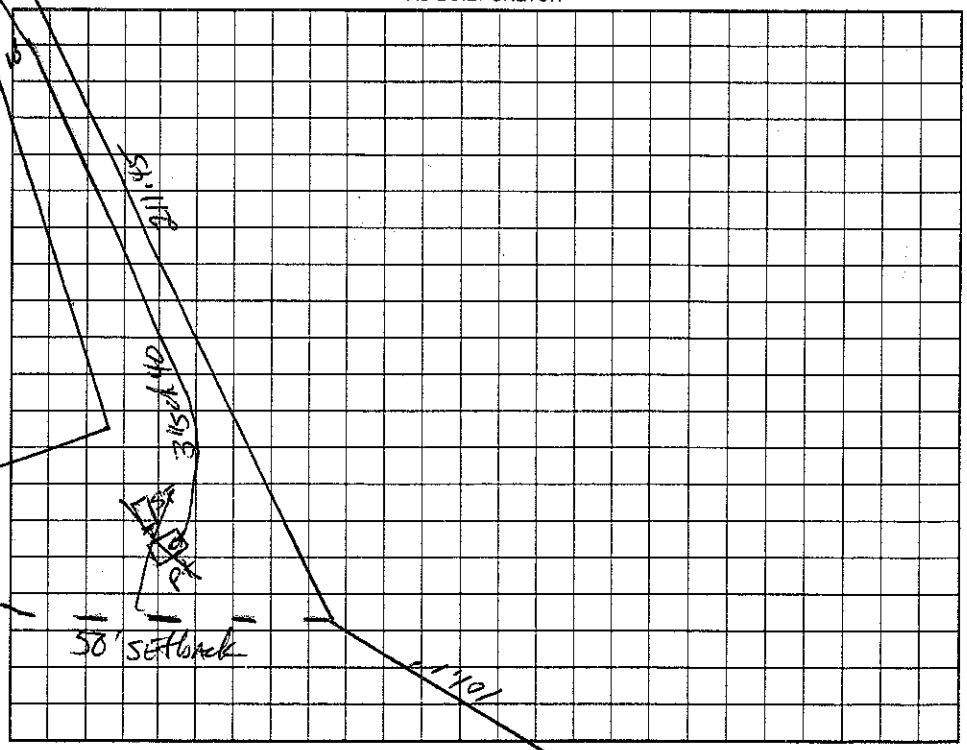

Permit can be suspended or revoked if any false information is supplied toward securing the permit/any unauthorized changes are made to the site/any unauthorized changes are made in the installation of the system. Improvement Permit with plat valid without expiration. Improvement Permit with site plan valid for sixty months. Authorization to Construct is valid for a period equal to that of Improvement Permit – not to exceed sixty months.

Signed: Robert B. Diehl date 1/29/02 Installed by: LN 178' RF Inc RS

Improvement Permit by: Donald Eatman, RS date 12-20-01 Operation Permit by: Maria H. Gibson date 2/23/04

Authorization to Construct by: E. Lyon RS date 6/5/03 Existing System Inspection by: _____ date _____

HEALTH DEPT. COPY: WHITE OWNER COPY (FINAL): YELLOW OWNER COPY (INITIAL): PINK