New Permit # 111679

IREDELL COUNTY HEALTH DEPARTMENT

STATESVILLE 704-878-5305 125.00 Paid MOORESVILLE 704-664-5281 10:00

IMPROVEMENT PERMIT / AUTHORIZATION TO CONSTRUCT / OPERATION PERMIT / EXISTING SYSTEM INSPECTION

PERMIT# 225 MRSJ. PIN# 4645-59-2250 4646-40-8544 DATE Dec 20, 01

OWNER OR CONTRACTOR Dienst Enterprises Inc. / ST Lawrence Homes PHONE: Business Home

ADDRESS 125 Easton Dr. Mooresville NC 28117 / 209 Templeton Bay

LOCATION 21S TL Alcove TR Templeton TR Templeton Bay at end

SUBDIVISION Templeton Bay BLOCK / SECTION LOT 42/42A LOT AREA 33527+/14400 sf SITE CLASS. PS DESIGN FLOW 480gpd L.T.A.R. .3 SFE 42A

Septic Tank: 1000 Gallons; STB 194 Date 9-10-03
Pump Tank: 1000 Gallons; PT 27 Date 9-2-03
Pump Make: MYERS Model PT-102 Serial No.
Nitrification Field: No Fields 1 Square Feet 1200 Linear Feet 400
No Lines 4@100 Trench Width 36" Max Trench Bottom Depth 36" Gravel Depth

☑ New System ☐ Repair System Type: I, II, (III), IV, V, VI
System Description: PM-Innovative-25%Red.
Repair System Description: LP Innovative or PPBPS
Maintenance Agreement Required: ☐ Yes ☑ No initially


☑ House/Mod. Home ☐ Mobile Home ☐ Business ☐ Other
No. Bedrooms 4/4 No. Bathrooms 4/4 No. Employees
☐ Slab ☐ Crawl Space ☑ Basement w/plumbing ☐ Basement wo/plumbing

Water Supply: ☐ Individual ☑ Public ☑ Community


Comments:/Conditions:
Remove any old burnes in septic field easement.

Comments:/Conditions: Cheaked tanks & lines 10/21/03

INITIAL SITE SKETCH

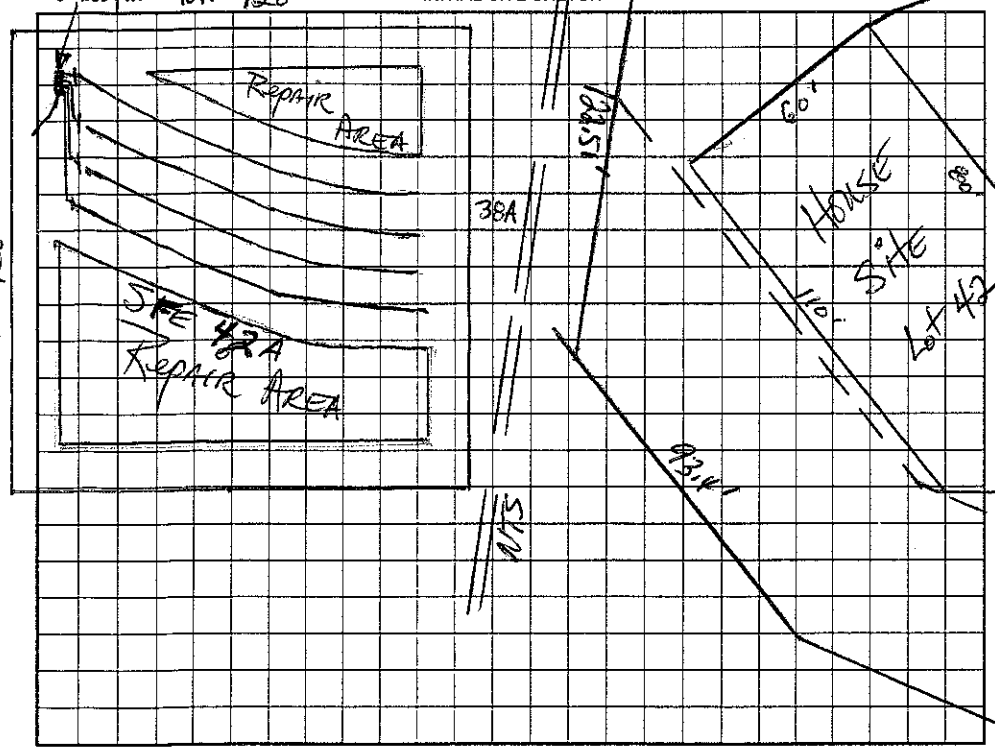

AS BUILT SKETCH

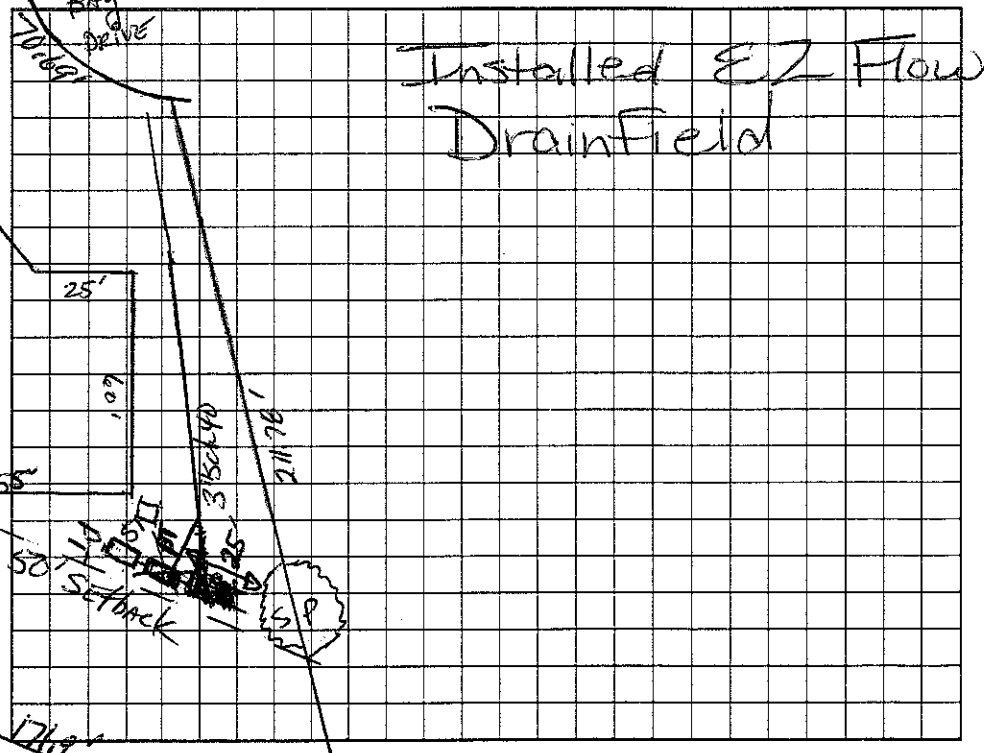

Permit can be suspended or revoked if any false information is supplied toward securing the permit/any unauthorized changes are made to the site/any unauthorized changes are made in the installation of the system. Improvement Permit with plot valid without expiration. Improvement Permit with site plan valid for sixty months. Authorization to Construct is valid for a period equal to that of Improvement Permit – not to exceed sixty months.

Signed: Robert B. Dienst date 1/29/02 Installed by: R & H Inc

Improvement Permit by: Melvin R. Hinson, LS date 12-20-01 Operation Permit by: Wesley Sparks RS. date 10/22/03

Authorization to Construct by: [signature] RS date 4/25/03 Existing System Inspection by: date

HEALTH DEPT. COPY: WHITE OWNER COPY (FINAL): YELLOW OWNER COPY (INITIAL): PINK