IREDELL COUNTY HEALTH DEPARTMENT

STATESVILLE 704-878-5305 MOORESVILLE 704-664-5281

IMPROVEMENT PERMIT / AUTHORIZATION TO CONSTRUCT / OPERATION PERMIT / EXISTING SYSTEM INSPECTION

PERMIT# 142740 PIN# 4646411554 DATE 5-11-07

OWNER OR APPLICANT Herbster Homes PHONE: Business 704 746-6979 Home

ADDRESS 152 Wood Duck Lp Mooresville, NC 28117

LOCATION Williamson Rd TL Alcove TR Catalina ~ 1/2 mile TL Knox Haven on left at cul-de-sac

SUBDIVISION Knox Haven BLOCK / SECTION LOT 6 LOT AREA .75 Acre SSITE CLASS. DESIGN FLOW 480gpd L.T.A.R. e 3

Septic Tank: 1000 Gallons; STB Date

Pump Tank: Gallons; PT Date

Pump Make: Model Serial No.

Nitrification Field: No Fields 1 Square Feet 1215 Linear Feet 405

No Lines 4 Trench Width 36" Max Trench Bottom Depth 36" Gravel Depth N/A

☒ New System ☐ Repair ☐ Expansion System Type: I II III IV V VI

System Description: Gravity - 25% Reduction

Repair System Description: LPP-PPBPS

Maintenance Agreement Required: ☐ Yes ☐ No

☒ House/Mod. Home No. Bedrooms 4

☐ Mobile Home No. Persons

☐ Business No. Employees

☐ Other


Water Supply: ☐ Individual ☒ Public ☐ Community

☐ Gravity ☐ Pressure ☐ Slab ☒ Crawl Space ☐ Basement w/plumbing ☐ Basement wo/plumbing

Comments/Conditions: Plan submitted by Rollans Soil & Environmental Services Inc. ☒ Existing well must be "properly abandoned" prior to Operation Permit.

Comments/Conditions: Final Completed 10/30/07 O.P. cannot be issued until abandonment well form received. A.C.

Scale 1:50 INITIAL SITE SKETCH

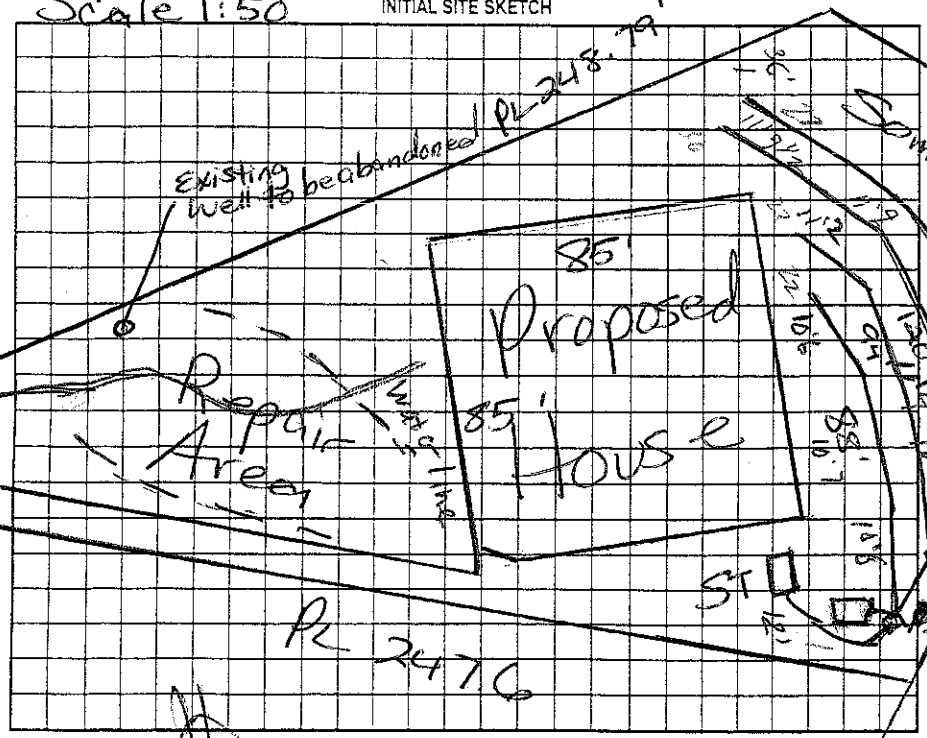

AS BUILT SKETCH

System installed as designed Improvements Completed & Installed. 10/30/07

2/21/08 Well abandonment received A.C.

Permit can be suspended or revoked if any false information is supplied toward securing the permit/any unauthorized changes are made to the site/any unauthorized changes are made in the installation of the system. Improvement Permit with plat valid without expiration ☐ Improvement Permit with site plan valid for sixty months ☐ Authorization to Construct is valid for a period equal to that of Improvement Permit – not to exceed sixty months.

Signed: date 5/10/07 Installed by: Richard Abernathy

Improvement Permit by: Maria H. Dolan R.S. date 5/1/07 Operation Permit by: Anthony Cole II date 2/21/08

Authorization to Construct by: Mary Melville date 5-16-07 Existing System Inspection by: date

HEALTH DEPT. COPY: WHITE OWNER COPY (FINAL): YELLOW OWNER COPY (INITIAL): PINK