IREDELL COUNTY HEALTH DEPARTMENT - *ENVIRONMENTAL HEALTH* ☐ STATESVILLE OFFICE 704-878-5305 ☐ MOORESVILLE OFFICE 704-664-5281

IMPROVEMENT PERMIT / AUTHORIZATION TO CONSTRUCT / OPERATION PERMIT / EXISTING SYSTEM INSPECTION

PERMIT # 150324 PIN # 4644641280346446412803 DATE 7-15-2011

OWNER Kelly Custom Homes APPLICANT: Lvisa Wilson PHONE: Home/Cell # 704936 7874 Business # 704 660-4511

SITE ADDRESS 114 Knox Haven Ln OWNER / APPLICANT ADDRESS P.O. Box 3276 Mooresville, NC 28117

SITE DIRECTIONS Williamson Rd TL Alcove Rd TR Catalina TL Knox Haven on Right

SUBDIVISION Knox Haven BLOCK / SECTION LOT # 9 LOT AREA .63 Acre DESIGN FLOW 480gpd L.T.A.R. .35

Septic Tank 1000 Gallons: STB 1012 Date 4-27-07 ☒ New System ☐ Repair ☐ Expansion System Type I II (III) IV V VI

Pump Tank 1000 Gallons: PT 17 Date 3-22-10 System Description: Pump-Pm-25% Reduction

Pump Make Goulds Model WE0312M Serial # G110100 Repair System Description: Pump-LP Panel Blk

No. Nitrification Fields: 1 No. Lines 4 Linear Feet 344' Maintenance Agreement Required ☐ YES ☒ NO

Trench Width 36" Max. Trench Bottom Depth 36" Gravel Depth N/A ☐ GRAVITY ☒ PRESSURE


☒ Residence No. Bedrooms 4 ☐ Business No. Persons ☐ Other No. Employees ☐ Slab ☒ Crawl Space ☐ Basement w/plumbing ☐ Basement w/o plumbing

Water Supply: ☐ Private ☒ Public ☐ Community


Comments / Conditions: Okay to skip over area where large Oak trees are to leave for repair. BA checked tanks 8/5/2011

8/9/11 Installed Quick 4, Used Splash Guards. 2ft pressure set 8/31/11

INITIAL SITE SKETCH

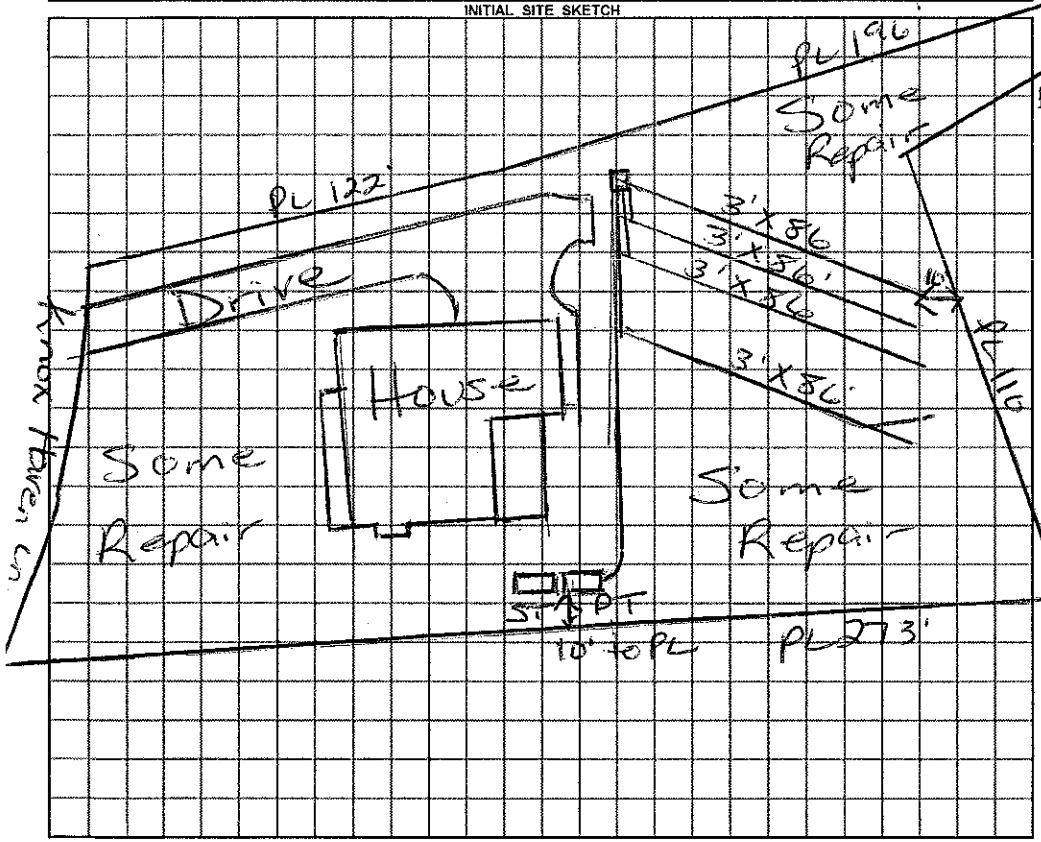

AS BUILT SKETCH

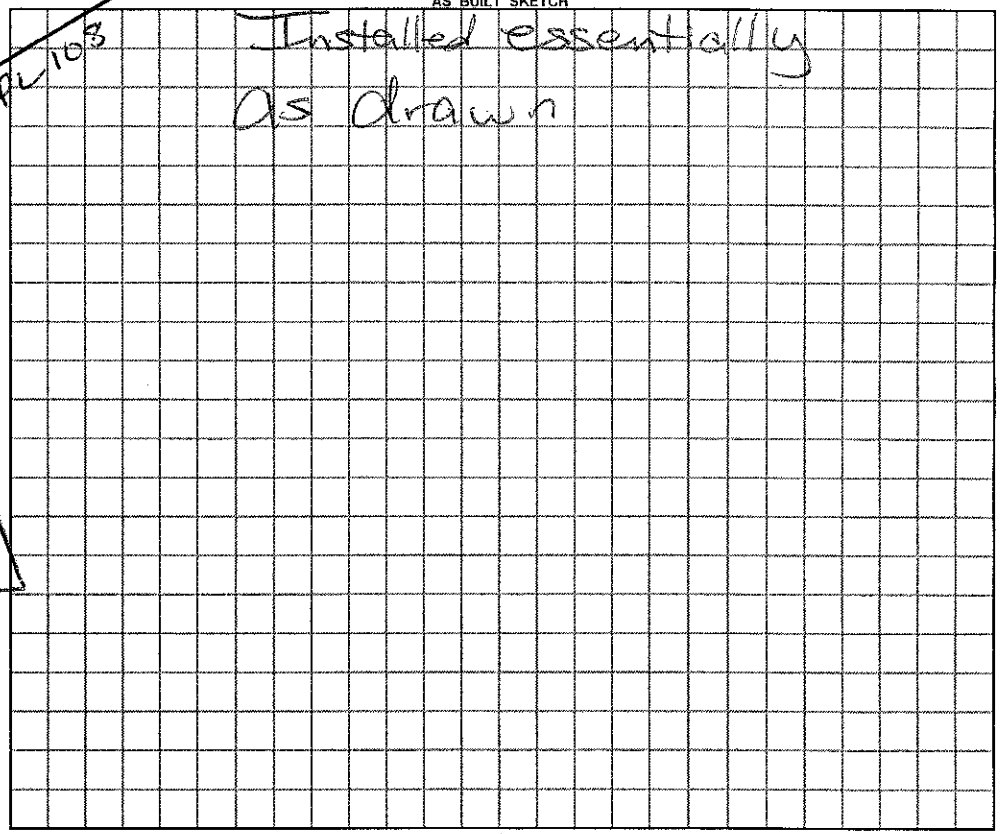

Permit can be suspended or revoked if any false information is supplied toward securing the permit / any unauthorized changes are made to the site / any unauthorized changes are made in the installation of the system.

☐ ***IMPROVEMENT PERMIT*** with plat valid without expiration. ☐ ***IMPROVEMENT PERMIT*** with plat valid without expiration. site plan valid 60 mo. ☐ ***AUTHORIZATION TO CONSTRUCT*** valid for period equal to IMPROVEMENT PERMIT--not to exceed 60 mo.

Owner / Applicant Signature: Michelle Hamrick RS Date 7/20/11 Installed by: Steve Jordon RS

IMPROVEMENT PERMIT by: Maint Hill Olson REHS Date 7/18/2011 OPERATION PERMIT by: Maint Hill Olson REHS Date 8/31/11

AUTHORIZATION TO CONSTRUCT by: Maint Hill Olson REHS Date 7/18/2011 Existing System Inspected by: REHS Date

YOU SHOULD CONTACT A LOCATOR SERVICE PRIOR TO ANY EXCAVATION

White Copy -- Environmental Health YELLOW COPY (Final) Owner / Applicant PINK COPY (Initial) Owner / Applicant